

PARENT PARCEL: 16-00-003-105-025 & -031, 16-00-004-000-006

CHILD PARCEL: XX-XX-XXX-XXX-XXX


STARTING POINT: S.E. CORNER OF O.L. 3

NO. 00002-D



# DEED CHECK

NEED ACREAGE BREAKDOWN ON DEED

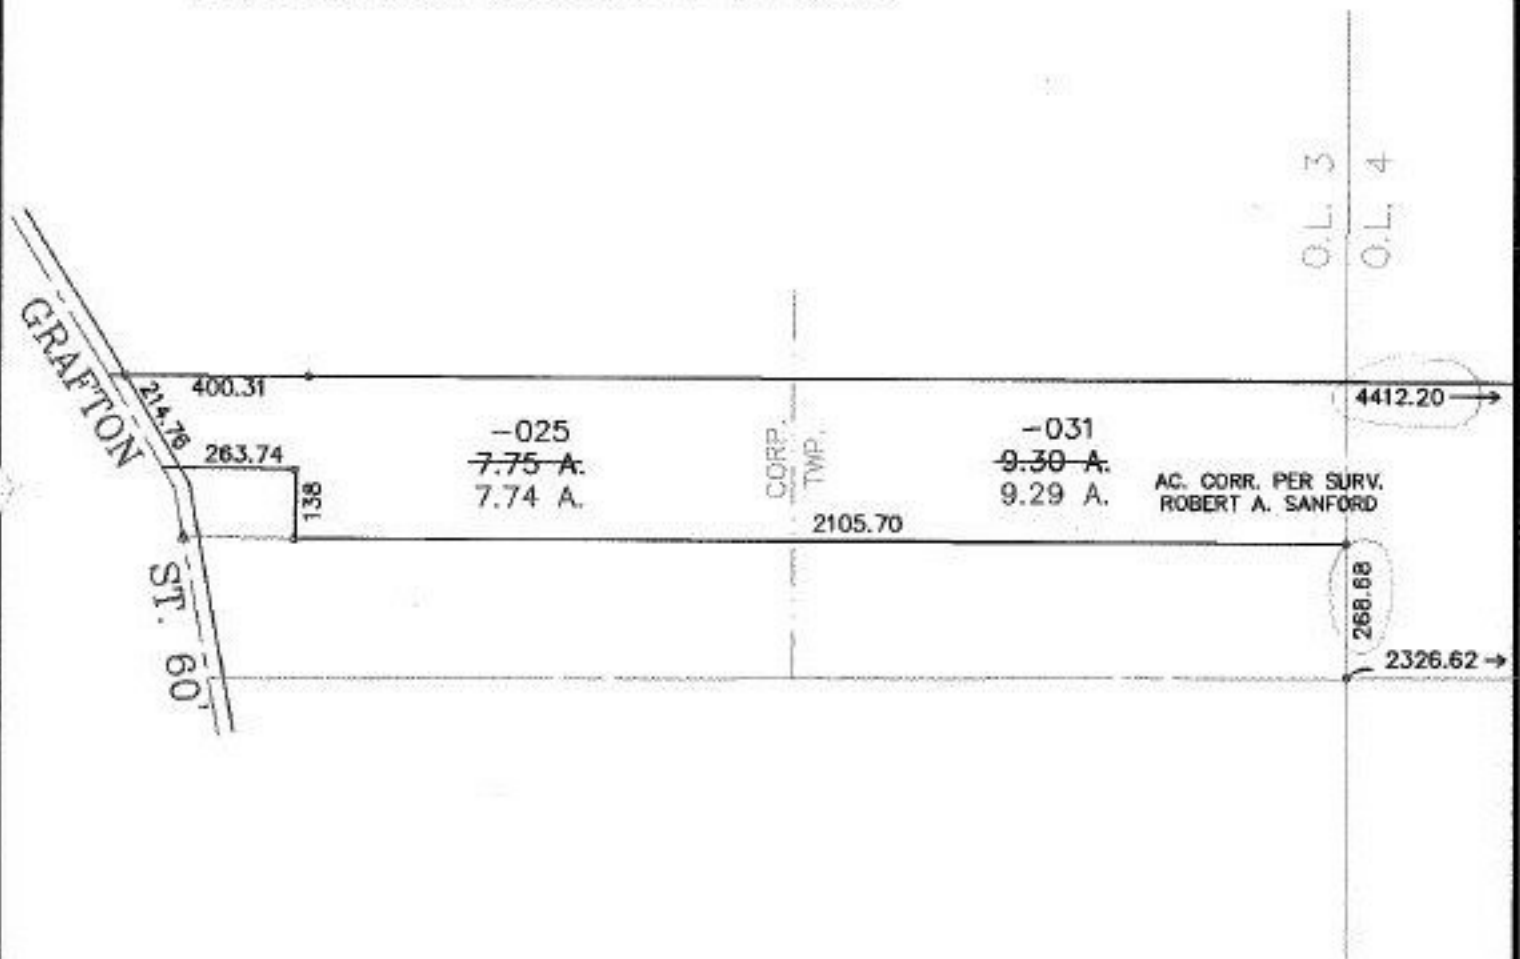

1 OF 2



**SPLITS/DEEDS PROCESSED**  
**LORAIN COUNTY TAX MAP DEPARTMENT**  
 226 MIDDLE AVE. ELYRIA, OHIO

SURVEYED BY: ROBERT A. SANFORD  
 CLOSURE: 0.01 : 10,000  
 MAP PAGE(S): 16-00-003-A & B  
 APPROVED BY: TJS DATE: 01/22/99  
 SCALE: 1" = 400' PRIOR INSTRUMENT: OR 1058/332