


PARENT PARCEL: 10-00-005-101-539


CHILD PARCEL: 10-00-005-101-623 & -624

STARTING POINT: CL OF WITTENBURG AVE. & CL OF CHESTNUT RIDGE RD.

NO. 00004

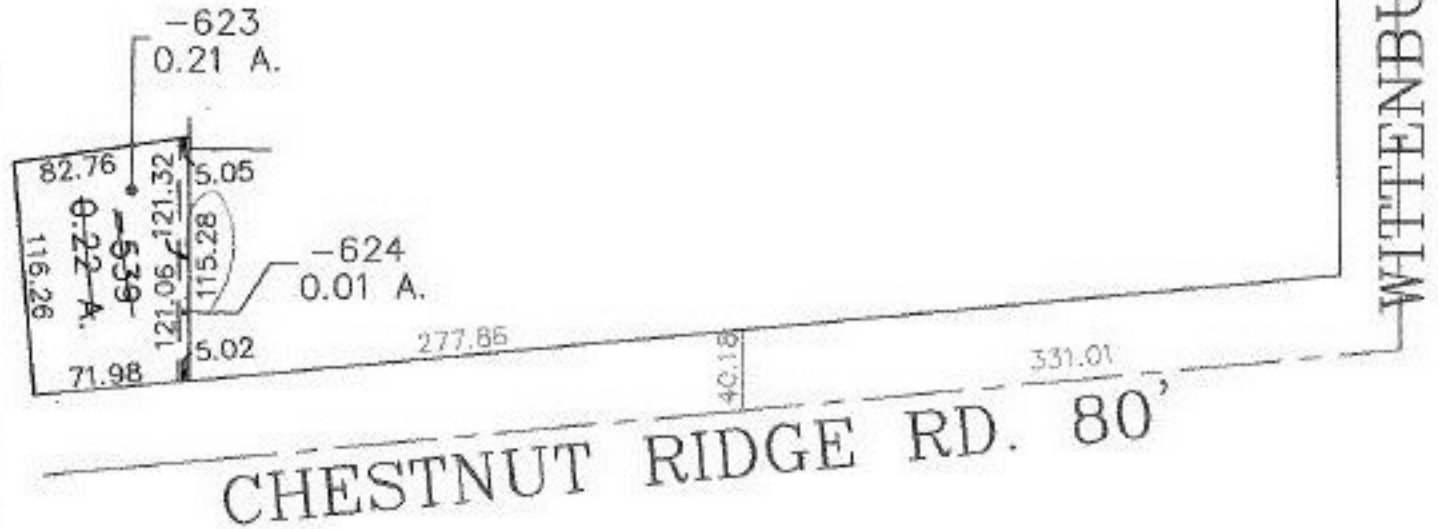

T3
2-16-00

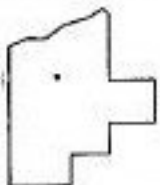

SPLITS/DEEDS PROCESSED

LORAIN COUNTY TAX MAP DEPARTMENT
226 MIDDLE AVE. ELYRIA, OHIO

SURVEYED BY:	DAVID L. ELWELL
CLOSURE:	0.07 : 10.000
MAP PAGE(S):	10-00-005-A
APPROVED BY:	IJS DATE: 02/11/99
SCALE:	1" = 100' PRIOR INSTRUMENT: OR 828/632