

PARENT PARCEL: 15-00-065-000-073




CHILD PARCEL: 15-00-065-000-095 & -096

STARTING POINT: MON. BOX, CL. OF WHITNEY RD. & S.W. CORNER OF O.L. 65

NO. 00007



POGACSNIK LANE 60'

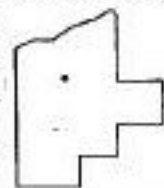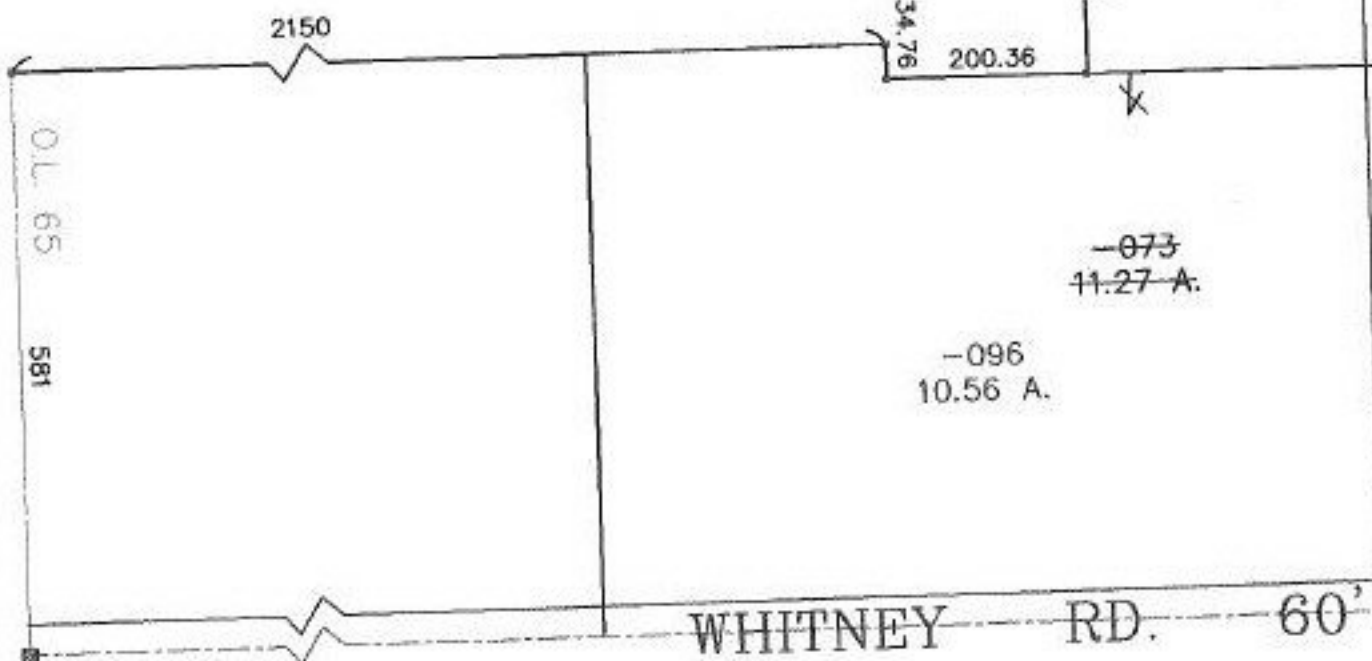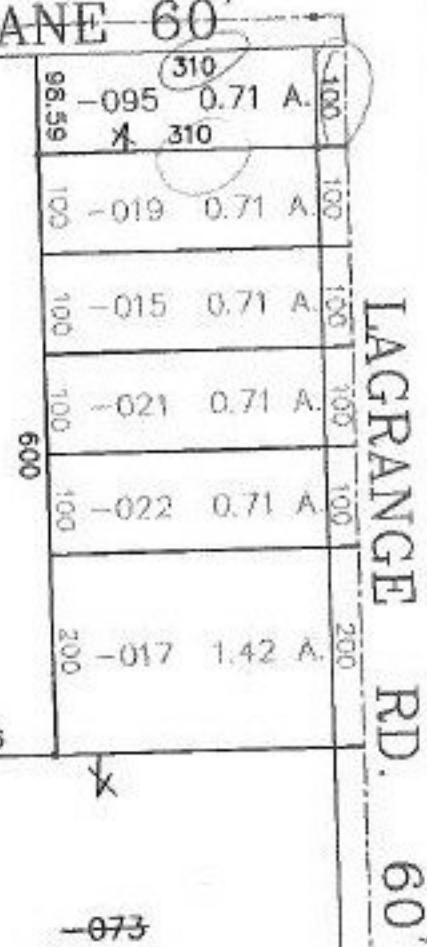

**SPLITS/DEEDS PROCESSED**  
 LORAIN COUNTY TAX MAP DEPARTMENT  
 226 MIDDLE AVE. ELYRIA, OHIO

SURVEYED BY: ROBERT C. KLAIBER JR.  
 CLOSURE: 0.15 : 10,000  
 MAP PAGE(S): 15-00-065-B  
 APPROVED BY: TJS DATE: 02/12/99  
 SCALE: 1" = 200 PRIOR INSTRUMENT: OR 769/576