


PARENT PARCEL: 09-00-090-000-095 & -104

CHILD PARCEL: 09-00-090-000-105 THRU -108

STARTING POINT: CL OF HALE RD. & S.E. CORNER OF S\L 1 IN THE EAST OBERLIN ALLOTMENT

NO. 00009

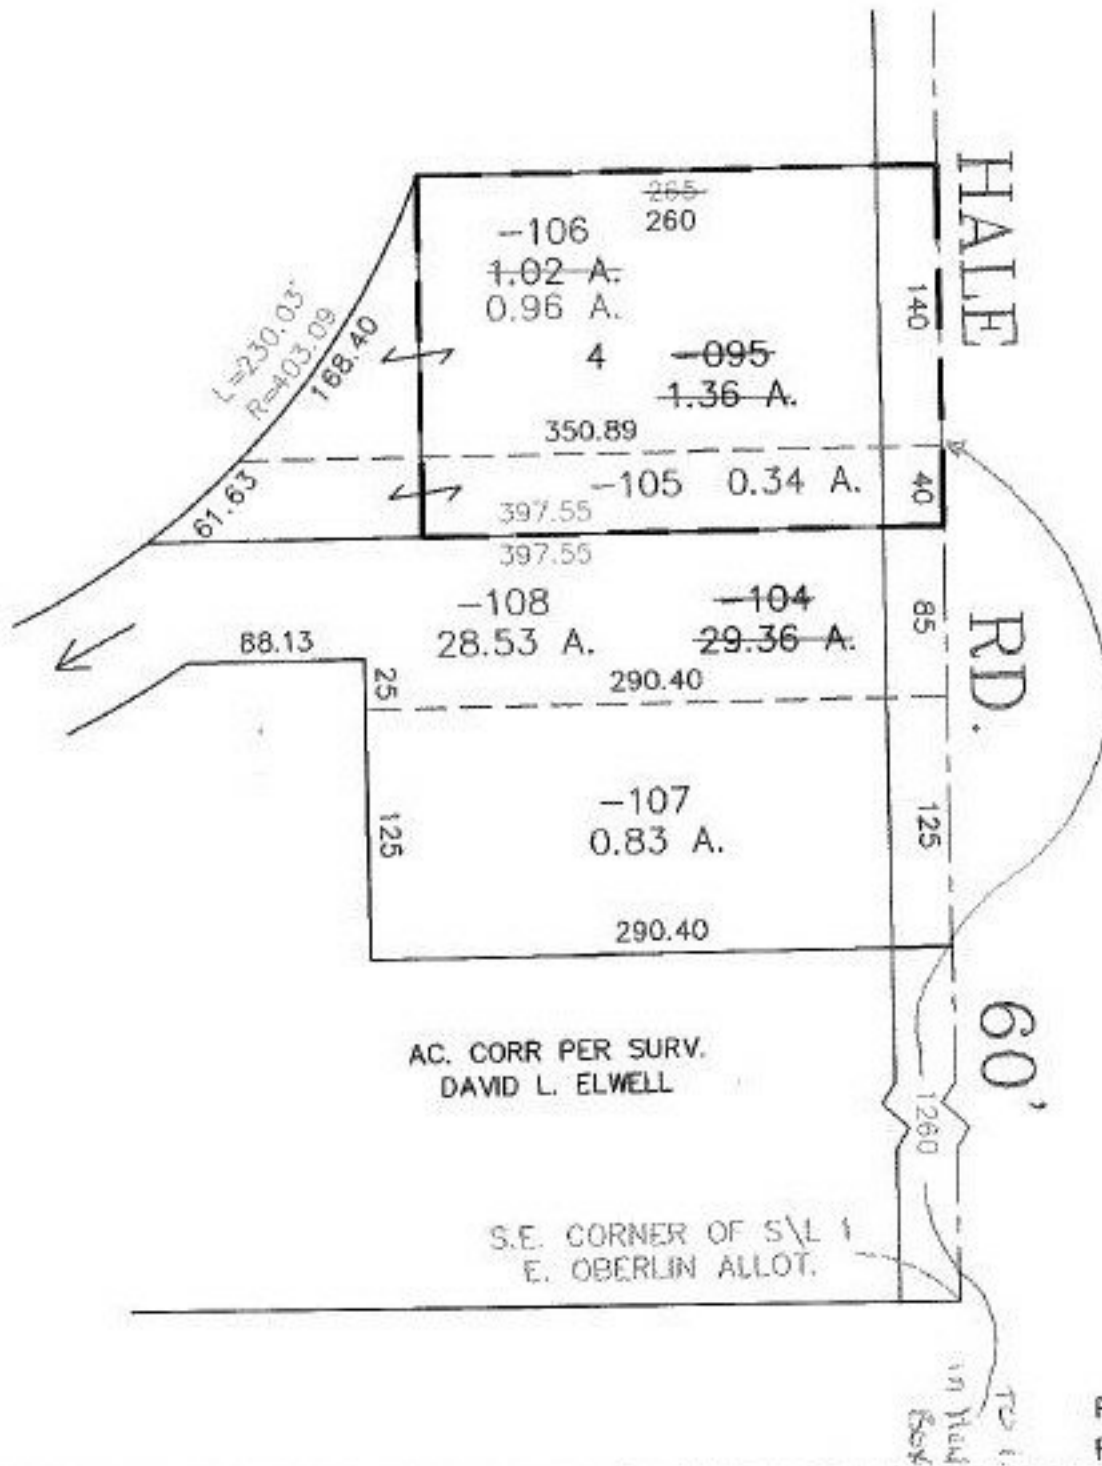

PRIOR INSTRUMENT: OR 62/697
PRIOR INSTRUMENT: OR 930/600

SURVEYED BY: DAVID L. ELWELL
CLOSURE: 0.07 : 10.000
MAP PAGE(S): 09-00-090-B
APPROVED BY: TJS DATE: 02/16/99
SCALE: 1" = 100'

SPLITS/DEEDS PROCESSED

LORAIN COUNTY TAX MAP DEPARTMENT
226 MIDDLE AVE. ELYRIA, OHIO

