

PARENT PARCEL: 18-00-044-000-050, & -036


CHILD PARCEL: XX-XX-XXX-XXX-XXX

STARTING POINT: CL OF QUARRY RD. & CL OF WALNUT VALLEY RD.

NO. 00016-X

MAP CHANGE ONLY

RED CORRECTIONS ON MAP PAGE
18-00-044-C ONLY

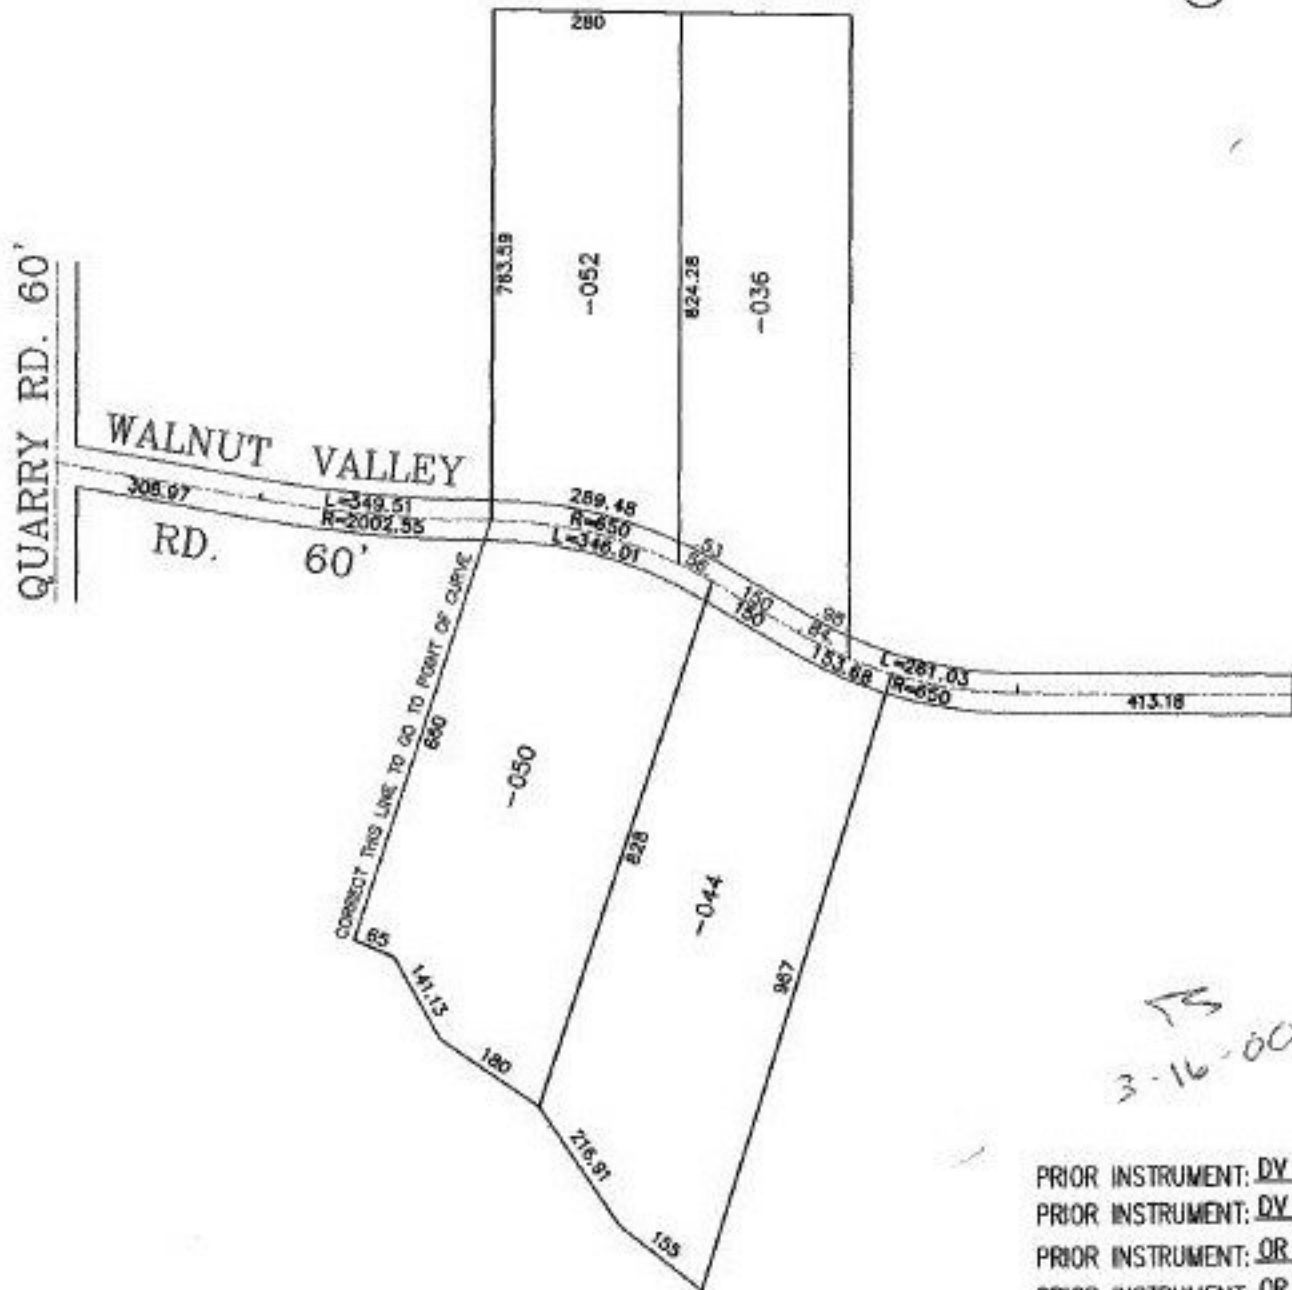

PRIOR INSTRUMENT: DV 1333/475
 PRIOR INSTRUMENT: DV 1352/346
 PRIOR INSTRUMENT: OR 814/697
 PRIOR INSTRUMENT: OR 710/81



SPLITS/DEEDS PROCESSED
 LORAIN COUNTY TAX MAP DEPARTMENT
 226 MIDDLE AVE. ELYRIA, OHIO

SURVEYED BY: NONE
 CLOSURE: 0.07 : 10,000
 MAP PAGE(S): 18-00-044-C, & A
 APPROVED BY: TJS DATE: 03/09/99
 SCALE: 1" = 300'