

PARENT PARCEL: 12-00-007-000-003

CHILD PARCEL: XX-XX-XXX-XXX-XXX

STARTING POINT: CL OF MARKS RD. & S.E. CORNER OF O.L. 7



NO. 00018-A

ACREAGE CORRECTION

12-00-007-000-003

~~42.00 A.~~

42.26 A.

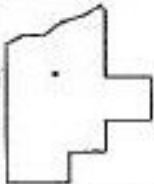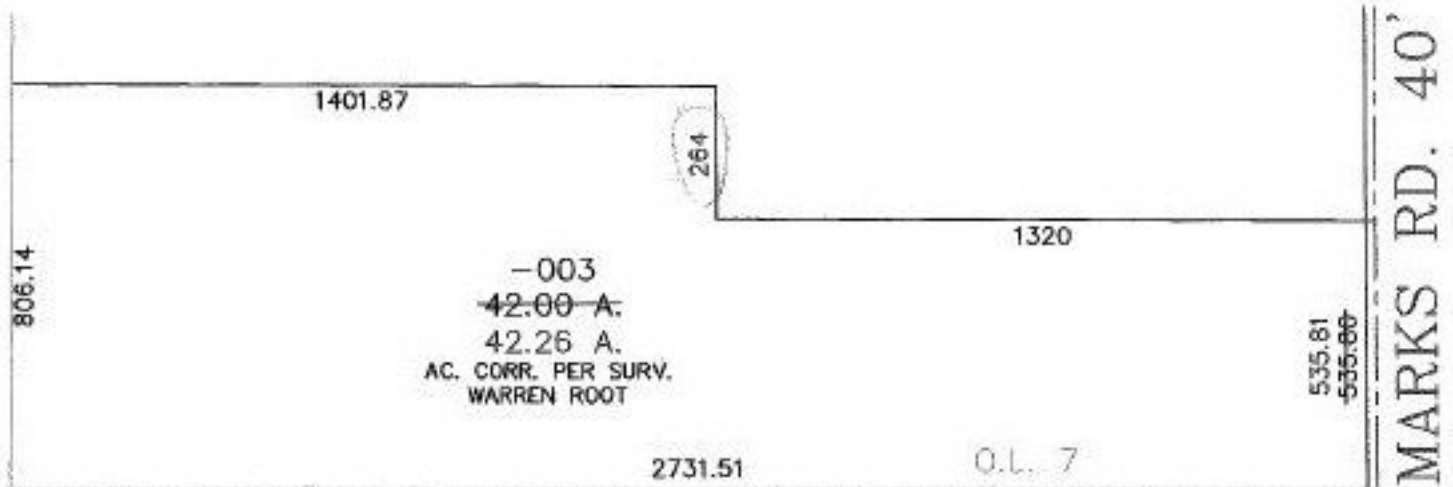

SPLITS/DEEDS PROCESSED
LORAIN COUNTY TAX MAP DEPARTMENT
 226 MIDDLE AVE. ELYRIA, OHIO

SURVEYED BY: WARREN ROOT
 CLOSURE: 0.01 : 10.000
 MAP PAGE(S): 12-00-007-A&B
 APPROVED BY: TJS DATE: 03/02/99
 SCALE: 1" = 400 PRIOR INSTRUMENT: DV 287/25