


PARENT PARCEL: 16-00-034-000-005, -021, & -023
 CHILD PARCEL: 16-00-034-000-024 THRU -027
 STARTING POINT: MON. BOX, CL OF ISLAND RD. & S.E. CORNER OF O.L. 34

NO. 00021



PRIOR INSTRUMENT: OR 1267 / 209
 PRIOR INSTRUMENT: 980576619

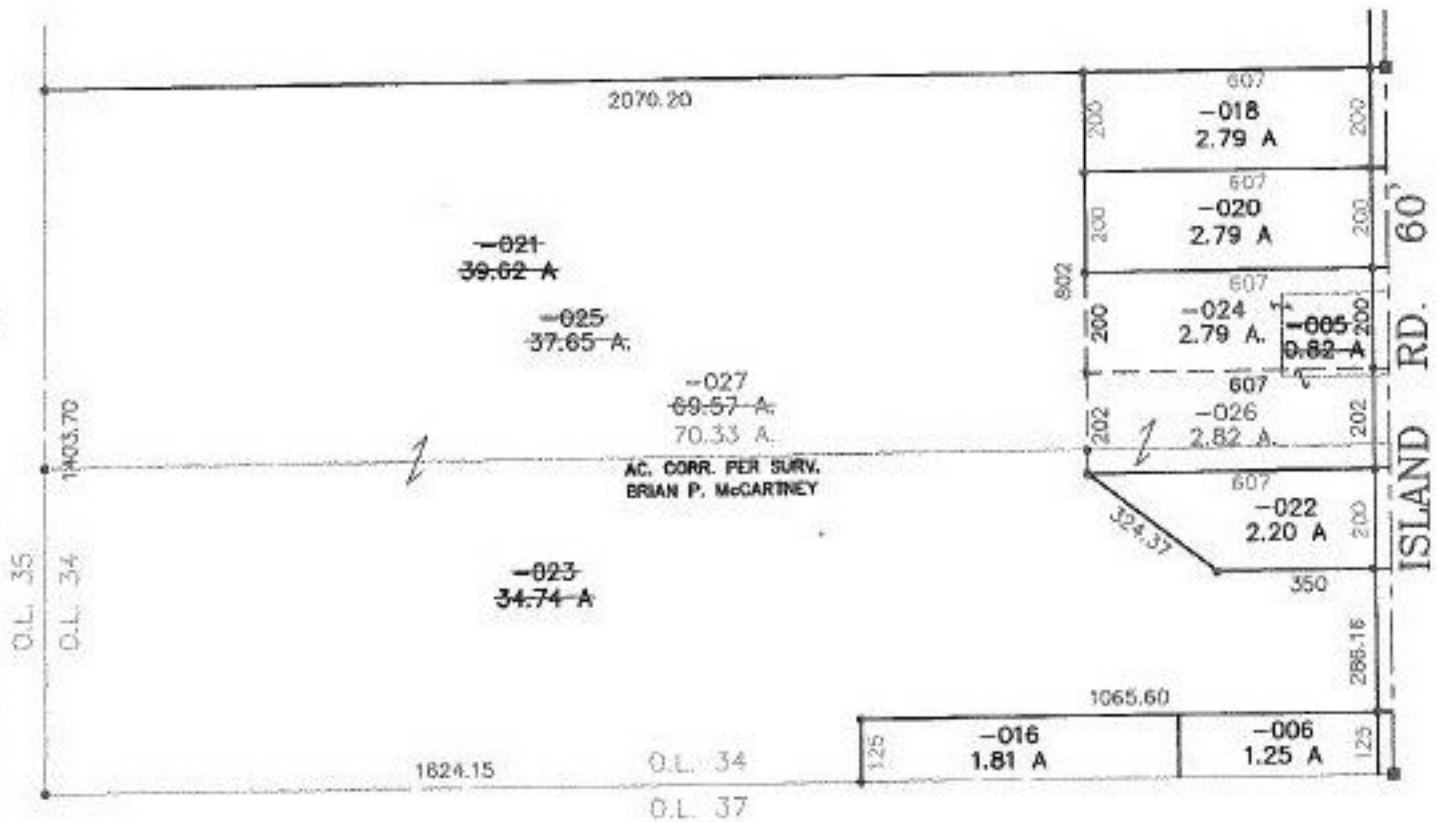

SPLITS/DEEDS PROCESSED
 LORAIN COUNTY TAX MAP DEPARTMENT
 226 MIDDLE AVE. ELYRIA, OHIO

SURVEYED BY: BRIAN P. MCCARTNEY
 CLOSURE: 0.01 : 10,000
 MAP PAGE(S): 16-C
 APPROVED BY: TJS DATE: 03/02/99
 SCALE: 1" = 400'