

PARENT PARCEL: 04-00-019-144-049


CHILD PARCEL: 04-00-019-144-351 & -352

STARTING POINT: CL OF ELECTRIC BLVD. & CL OF BECK RD.

NO. 00022



ELECTRIC BLVD. 80'

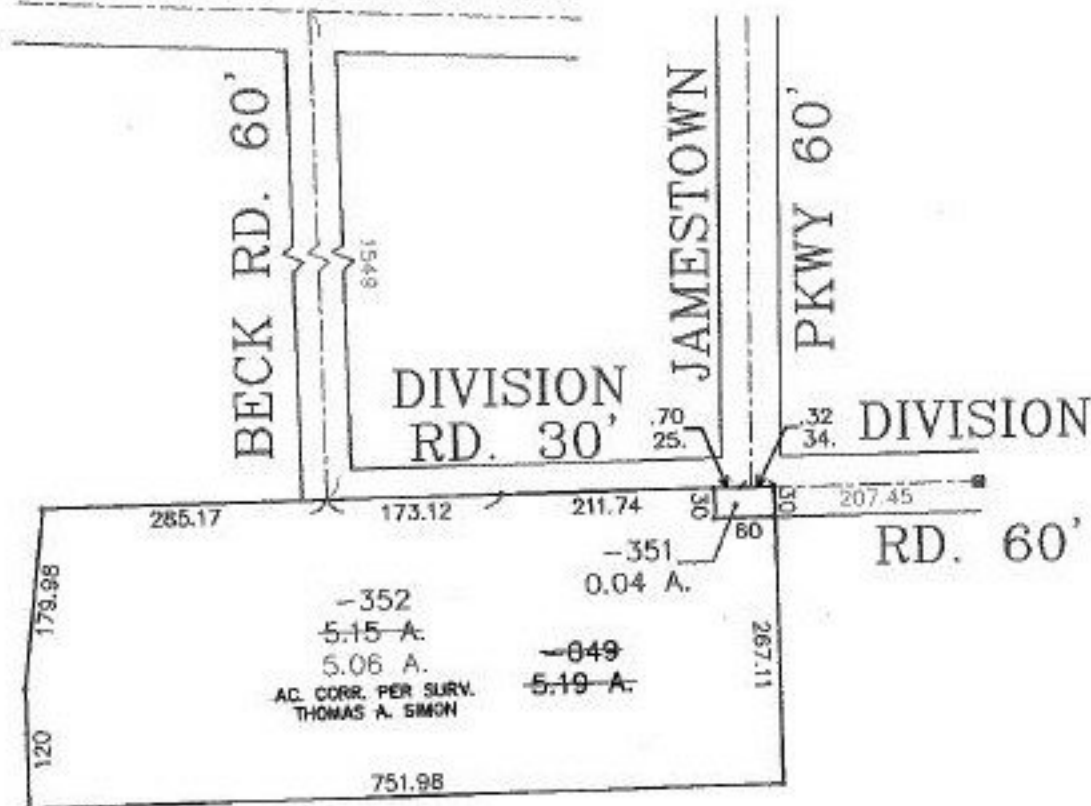

SPLITS/DEEDS PROCESSED
LORAIN COUNTY TAX MAP DEPARTMENT
226 MIDDLE AVE. ELYRIA, OHIO

SURVEYED BY: THOMAS A. SIMON
 CLOSURE: 0.20 : 10.000
 MAP PAGE(S): 04-00-019-G
 APPROVED BY: TJS DATE: 03/25/99
 SCALE: 1" = 200' PRIOR INSTRUMENT: OR 529/204