

PARENT PARCEL: 01-20-027-102-036

CHILD PARCEL: 01-20-027-102-049 & -050

STARTING POINT: CL OF LAKE RD. & THE WEST LINE OF BROWNHELM TWP.

NO. 00025-U

# UNCOMBINATION


~~01-20-027-102-036~~  
1.27 A.

01-20-027-102-049  
0.11 A.

01-20-027-102-050  
1.16 A.



## LAKE RD.

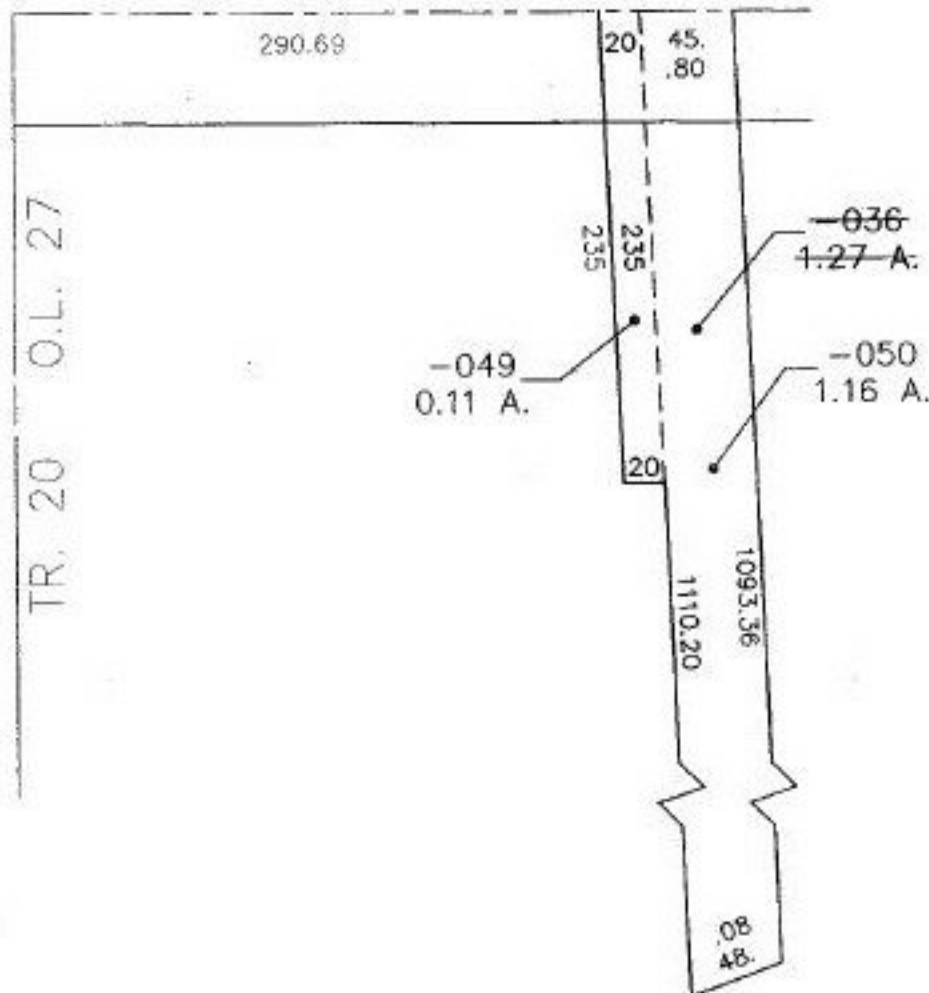

### SPLITS/DEEDS PROCESSED

LORAIN COUNTY TAX MAP DEPARTMENT  
226 MIDDLE AVE. ELYRIA, OHIO

SURVEYED BY: LOUIS A. SCHULTZ

CLOSURE: CAN'T RUN

MAP PAGE(S): 01-00-001-C

APPROVED BY: TJS DATE: 03/19/99

SCALE: 1" = 100' PRIOR INSTRUMENT: OR 638/580