


PARENT PARCEL: 04-00-015-109-052, -054, & -110  
CHILD PARCEL: 04-00-015-109-161 THRU -163  
STARTING POINT: CL. OF DETROIT RD. & CL. OF HEALTHWAY DR.

NO. 00027

HEALTHWAY  
DR.

DETROIT RD.

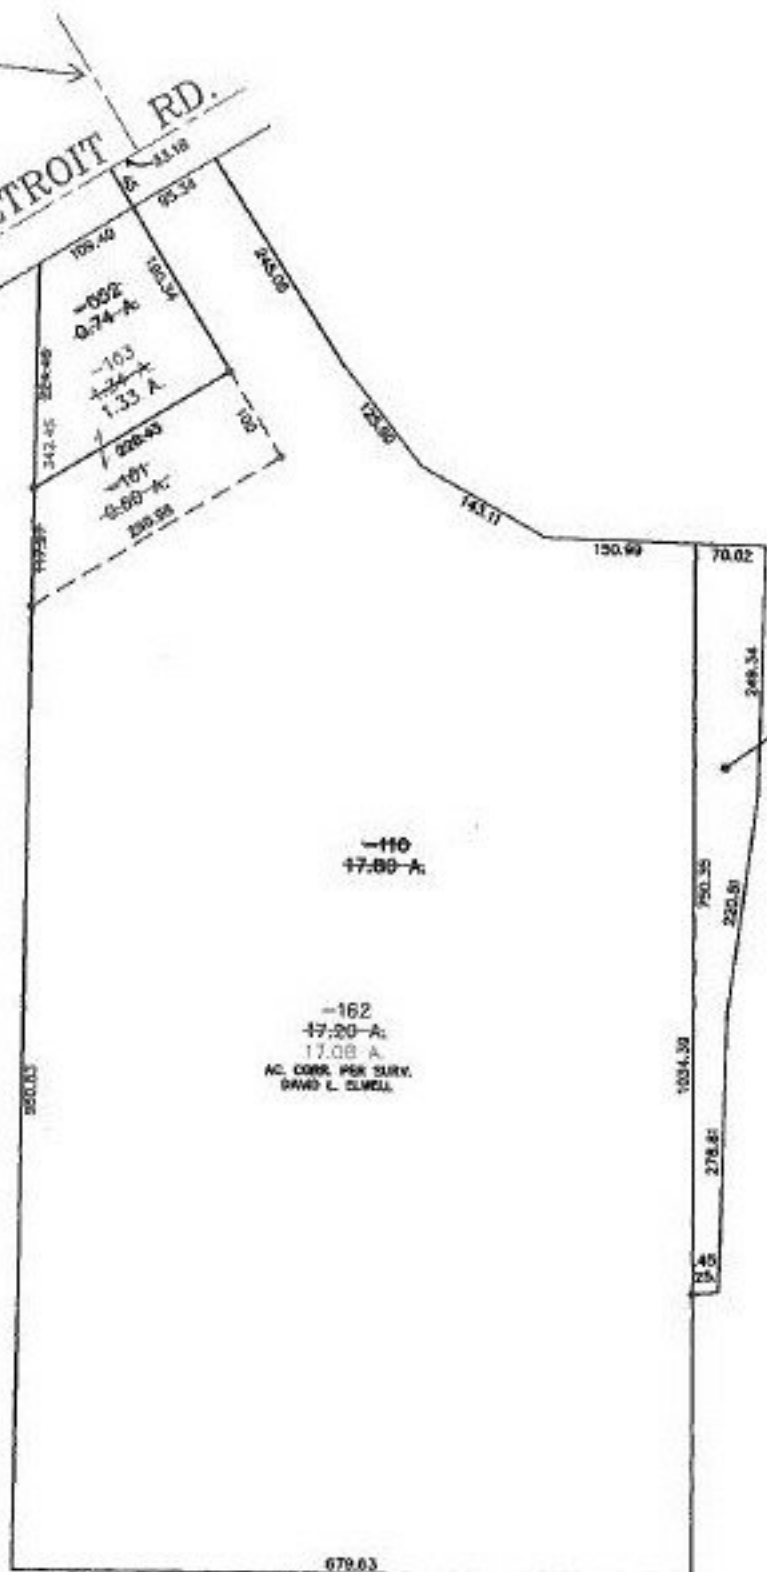

-054  
0.82-A  
AC. CORR. PER SURV.  
DAVID L. ELWELL

-110  
17.88-A

-162  
17.88-A  
AC. CORR. PER SURV.  
DAVID L. ELWELL



**SPLITS/DEEDS PROCESSED**  
LORAIN COUNTY TAX MAP DEPARTMENT  
226 MIDDLE AVE. ELYRIA, OHIO

SURVEYED BY: DAVID L. ELWELL  
CLOSURE: 0.07 : 10.000  
MAP PAGE(S): 04-00-015-B & F  
APPROVED BY: TJS DATE: 06/02/99  
SCALE: 1" = 200' PRIOR INSTRUMENT: OR 590/493