


PARENT PARCEL: 07-00-004-104-022 & -034

CHILD PARCEL: 07-00-004-104-065 THRU -067


STARTING POINT: MON. BOX, CL. OF MILLS CREEK RD. & CL. OF CHESTNUT RIDGE RD.

NO. 00028

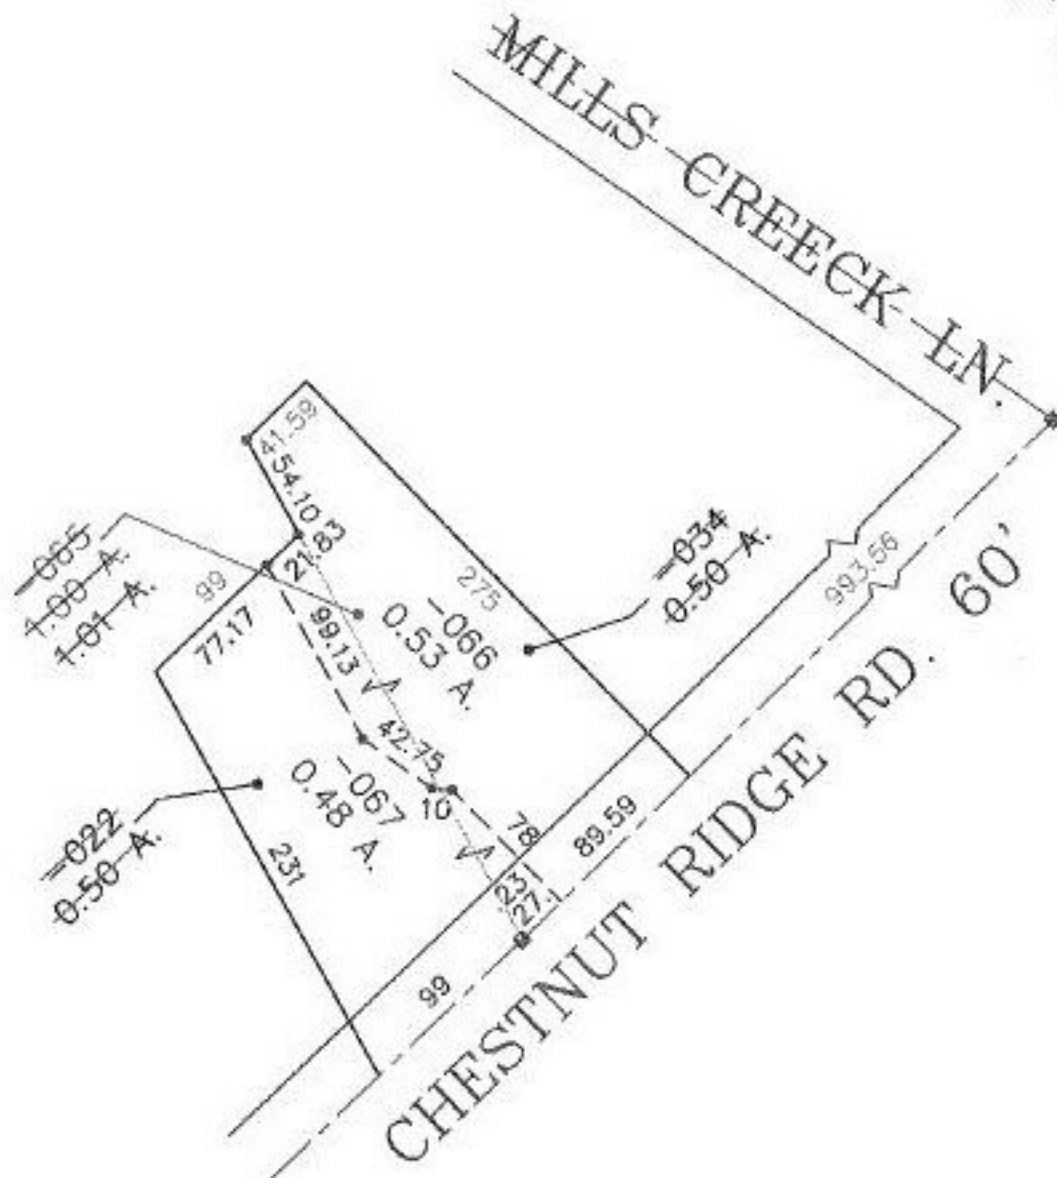

PRIOR INSTRUMENT: DV 1125/625

PRIOR INSTRUMENT: DV 1055/729

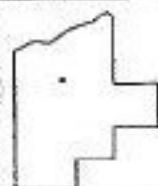

SPLITS/DEEDS PROCESSED

LORAIN COUNTY TAX MAP DEPARTMENT
226 MIDDLE AVE. ELYRIA, OHIO

SURVEYED BY: DANE A. HAPONEK

CLOSURE: 0.08 : 10.000

MAP PAGE(S): 07-00-004-B

APPROVED BY: TJS DATE: 03/09/99

SCALE: 1" = 100'