


PARENT PARCEL: 04-00-029-000-031

CHILD PARCEL: XX-XX-XXX-XXX-XXX *NA*

STARTING POINT: CL OF LEAR NAGLE RD. & CL OF KREBS RD.

NO. 00029-A

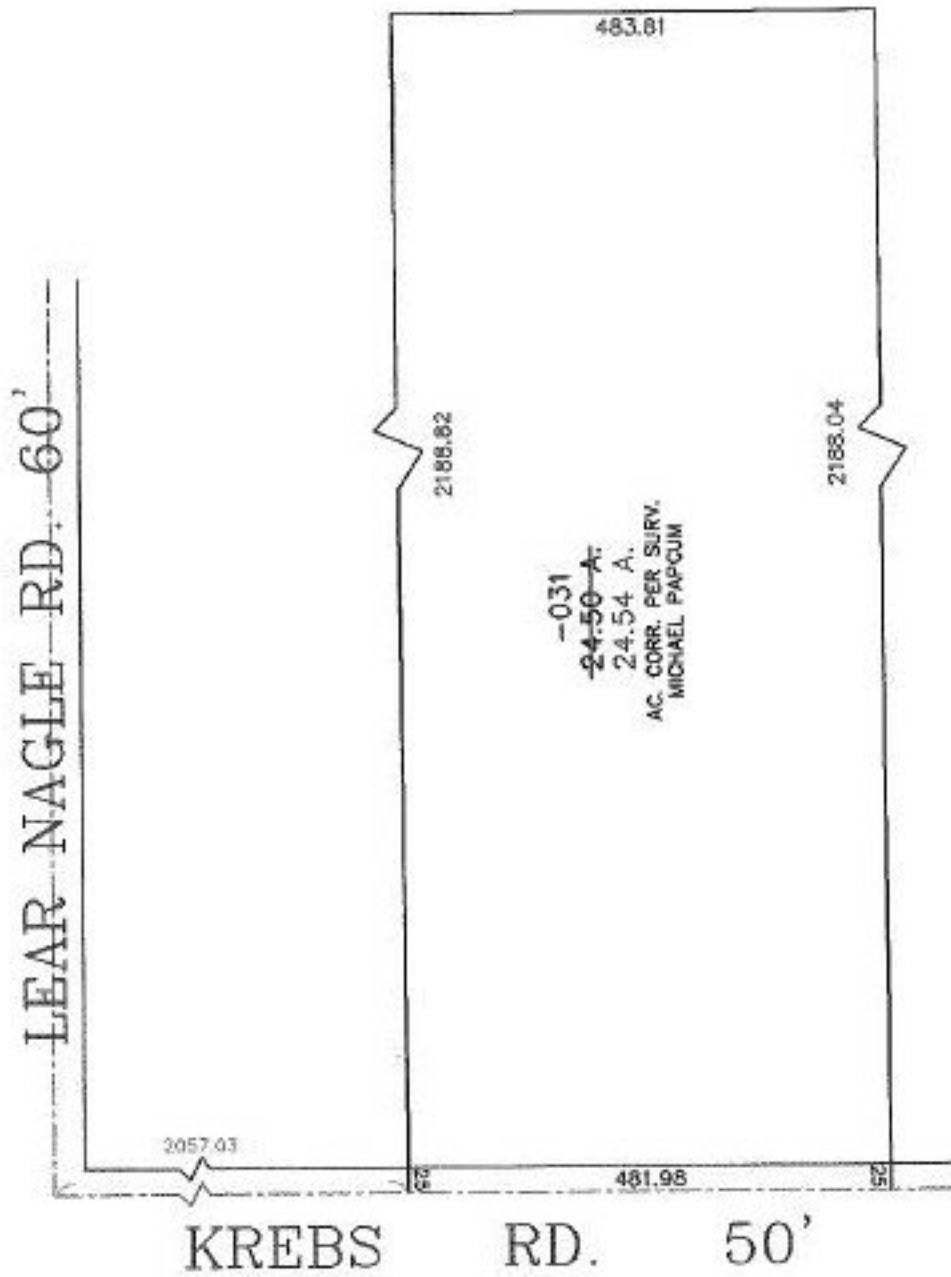

SPLITS/DEEDS PROCESSED
 LORAIN COUNTY TAX MAP DEPARTMENT
 226 MIDDLE AVE. ELYRIA, OHIO

SURVEYED BY: MICHAEL PAPCUM
 CLOSURE: NA
 MAP PAGE(S): 4-D
 APPROVED BY: TJS DATE: 04/21/99
 SCALE: 1" = 200' PRIOR INSTRUMENT: DV 1164/898