

PARENT PARCEL: 10-00-005-101-515

CHILD PARCEL: 10-00-005-101-625 & -626

STARTING POINT: N.E. CORNER OF S/L 207 OF UNIVERSITY OAKS SUB. NO. 7



NO. 00029

NEW PARCELS

10-00-005-101-515
46.81 X 156.01

10-00-005-101-625
39.82 X 108.23 TRI.

10-00-005-101-626
46.81 X 144.70

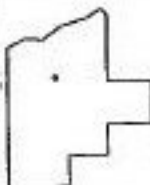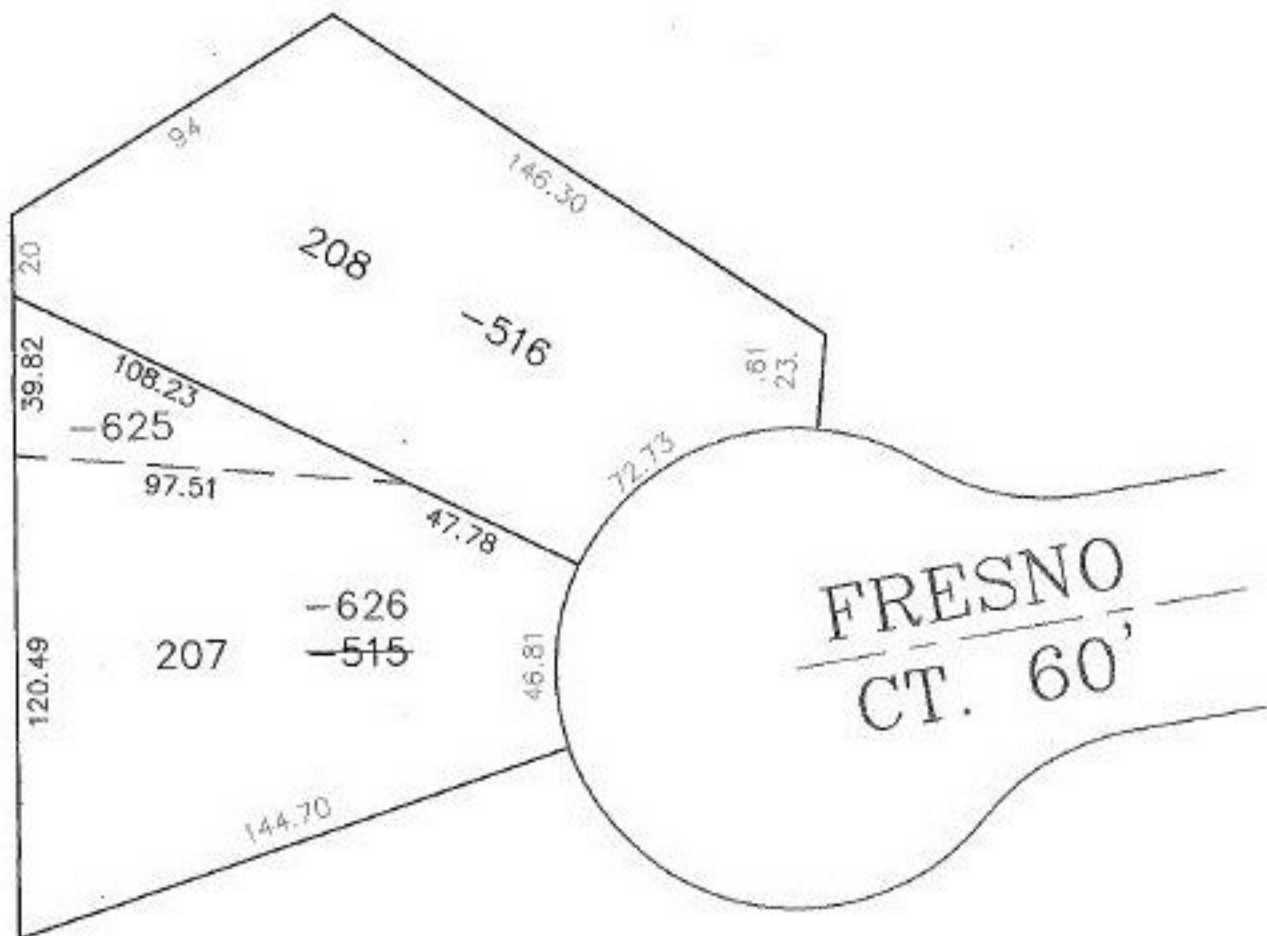

SPLITS/DEEDS PROCESSED
LORAIN COUNTY TAX MAP DEPARTMENT
226 MIDDLE AVE. ELYRIA, OHIO

SURVEYED BY:	RODGER G. SIMON
CLOSURE:	0.12 : 10,000
MAP PAGE(S):	10-00-005-A
APPROVED BY:	IJS
DATE:	09/10/99
SCALE:	1" = 50'
PRIOR INSTRUMENT:	OR 978/890