


PARENT PARCEL: 15-00-062-000-032

CHILD PARCEL: 15-00-062-000-035 & -036

STARTING POINT: MON. BOX, CL. OF WHITNEY RD. & CL. OF NICKLE PLATE-DIAGONAL RD.

NO. 00030

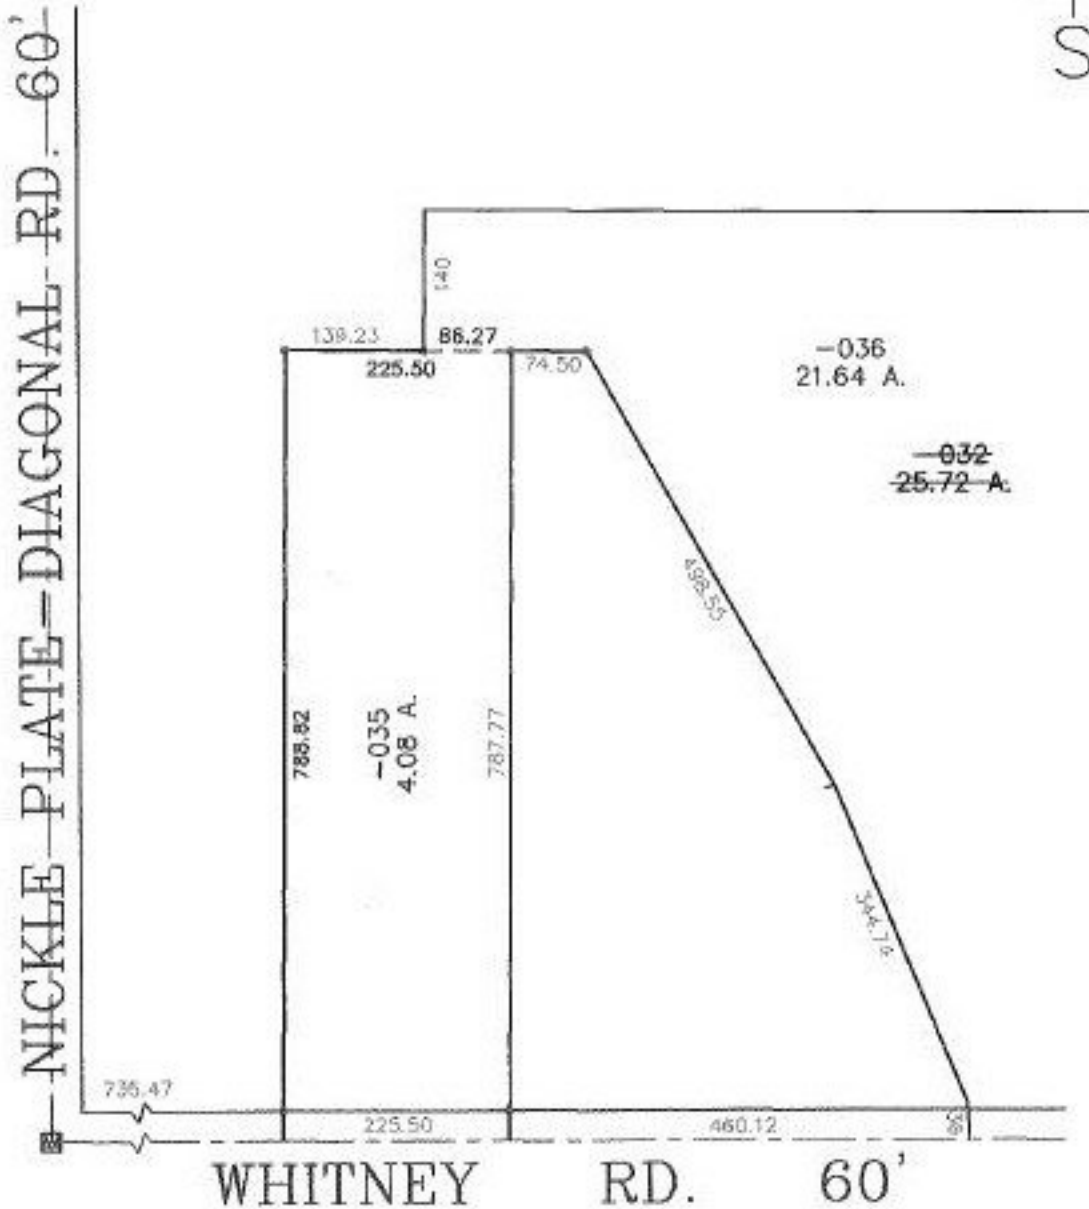

PRIOR INSTRUMENT: OR 1381/296

PRIOR INSTRUMENT: 980516938



SPLITS/DEEDS PROCESSED
 LORAIN COUNTY TAX MAP DEPARTMENT
 226 MIDDLE AVE. ELYRIA, OHIO

SURVEYED BY: RODGER G. SIMON

CLOSURE: 0.02 : 10,000

MAP PAGE(S): 15-E

APPROVED BY: TJS DATE: 03/09/99

SCALE: 1" = 200'