


PARENT PARCEL: 03-00-014-000-049

CHILD PARCEL: XX-XX-XXX-XXX-XXX

STARTING POINT: CL. OF ABBE RD. & NORTH LINE OF O.L. 14

NO. 00035-A

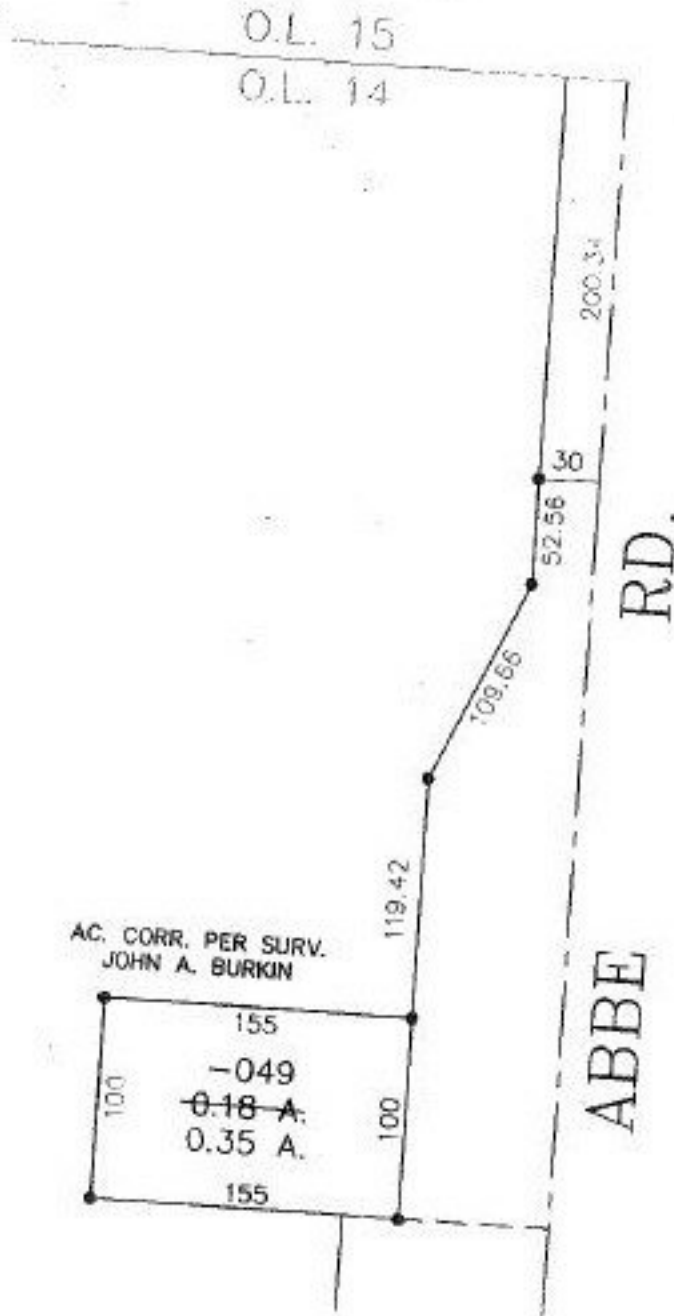

SPLITS/DEEDS PROCESSED

LORAIN COUNTY TAX MAP DEPARTMENT
226 MIDDLE AVE. ELYRIA, OHIO

SURVEYED BY: JOHN A. BURKIN

CLOSURE: 0.00 : 10,000

MAP PAGE(S): 03-00-014-B

APPROVED BY: TJS DATE: 04/09/99

SCALE: 1" = 100. PRIOR INSTRUMENT: 990601998