



PARENT PARCEL: 18-00-039-000-018 & -019
CHILD PARCEL: XX-XX-XXX-XXX-XXX
STARTING POINT: CL OF PITTS RD. & SOUTH LINE OF O.L. 39

NO. 00035

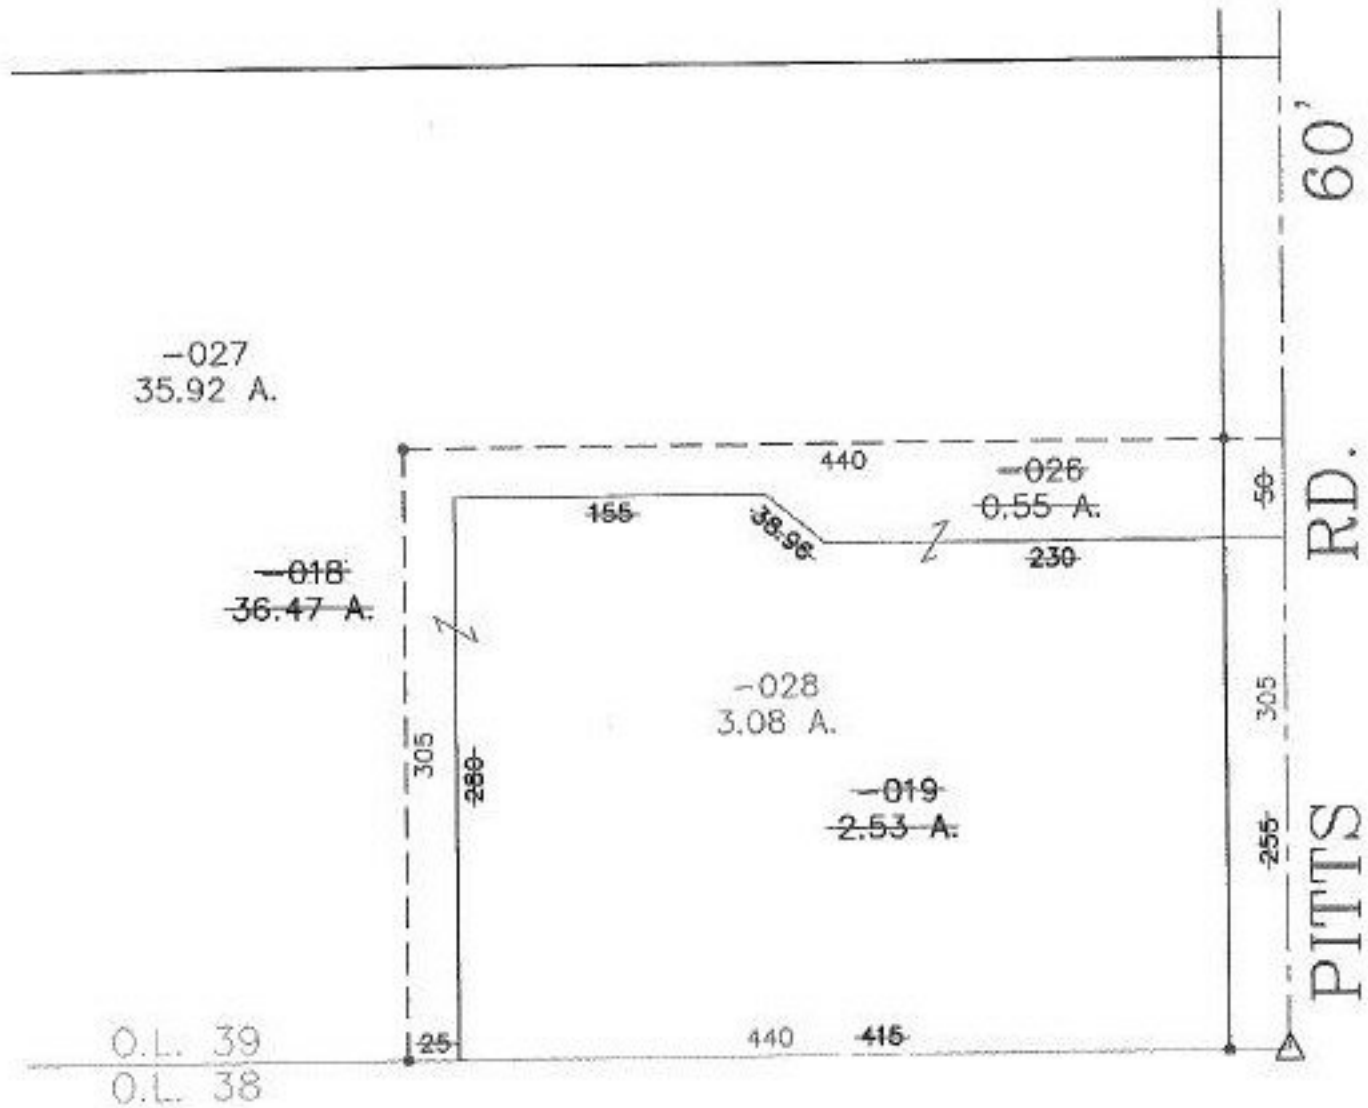

PRIOR INSTRUMENT: DV 1131/616
PRIOR INSTRUMENT: DV 1170/736

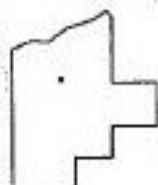

SPLITS/DEEDS PROCESSED
LORAIN COUNTY TAX MAP DEPARTMENT
226 MIDDLE AVE. ELYRIA, OHIO

SURVEYED BY: THOMAS M. SNEZEK
CLOSURE: 0.00 : 10.000
MAP PAGE(S): 18-E
APPROVED BY: TJS DATE: 03/26/99
SCALE: 1" = 100' PRIOR INSTRUMENT: DV 1131/616