
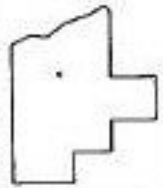


PARENT PARCEL: 04-00-021-000-162

CHILD PARCEL: 04-00-021-000-169 THRU -171

STARTING POINT: PARCEL 1: P.K. NAIL IN THE CL OF LEAR-NAGLE RD. & CL OF LEAR INDUSTRIAL PKWY
PARCEL 2:

NO. 00047

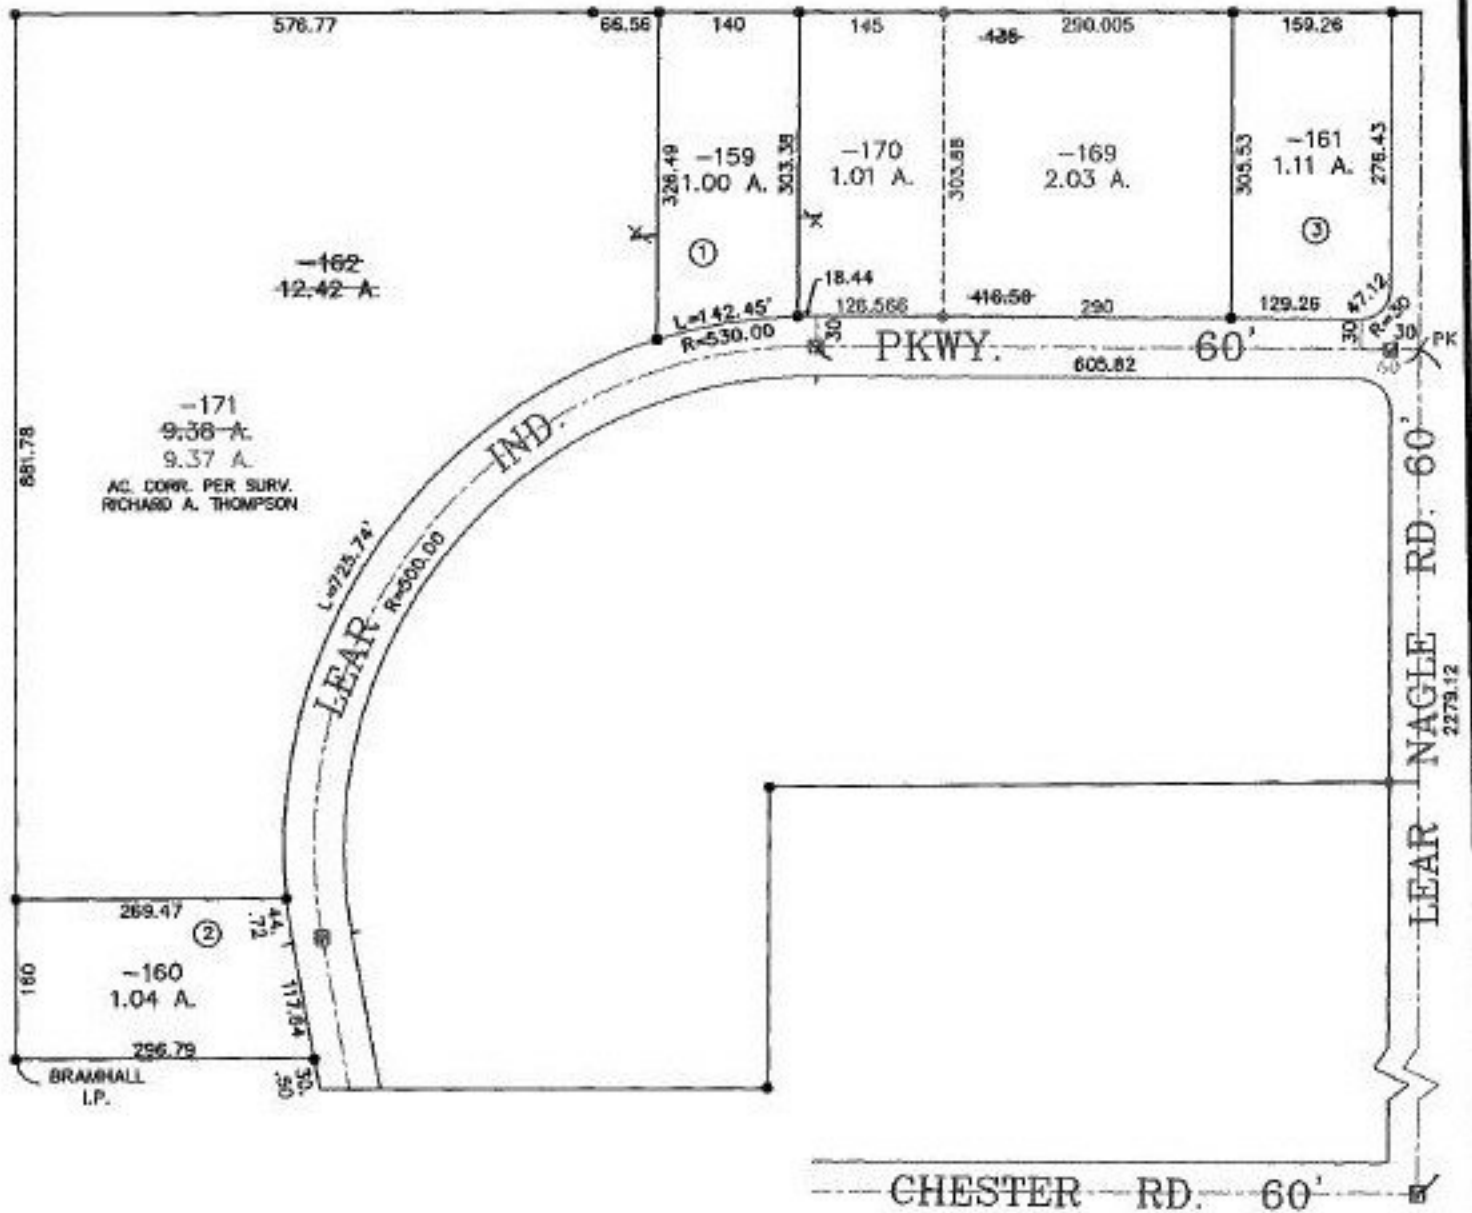

SPLITS/DEEDS PROCESSED
LORAIN COUNTY TAX MAP DEPARTMENT
226 MIDDLE AVE. ELYRIA, OHIO

SURVEYED BY: RICHARD A. THOMPSON JR.
 CLOSURE: 0.07 : 10,000
 MAP PAGE(S): 4-G
 APPROVED BY: TJS DATE: 04/07/99
 SCALE: 1" = 200' PRIOR INSTRUMENT: OR 1303/813