


PARENT PARCEL: 04-00-021-000-157

CHILD PARCEL: 04-00-021-000-172 THRU -174

STARTING POINT: PARCEL 1

PARCEL 2:

NO. 00048

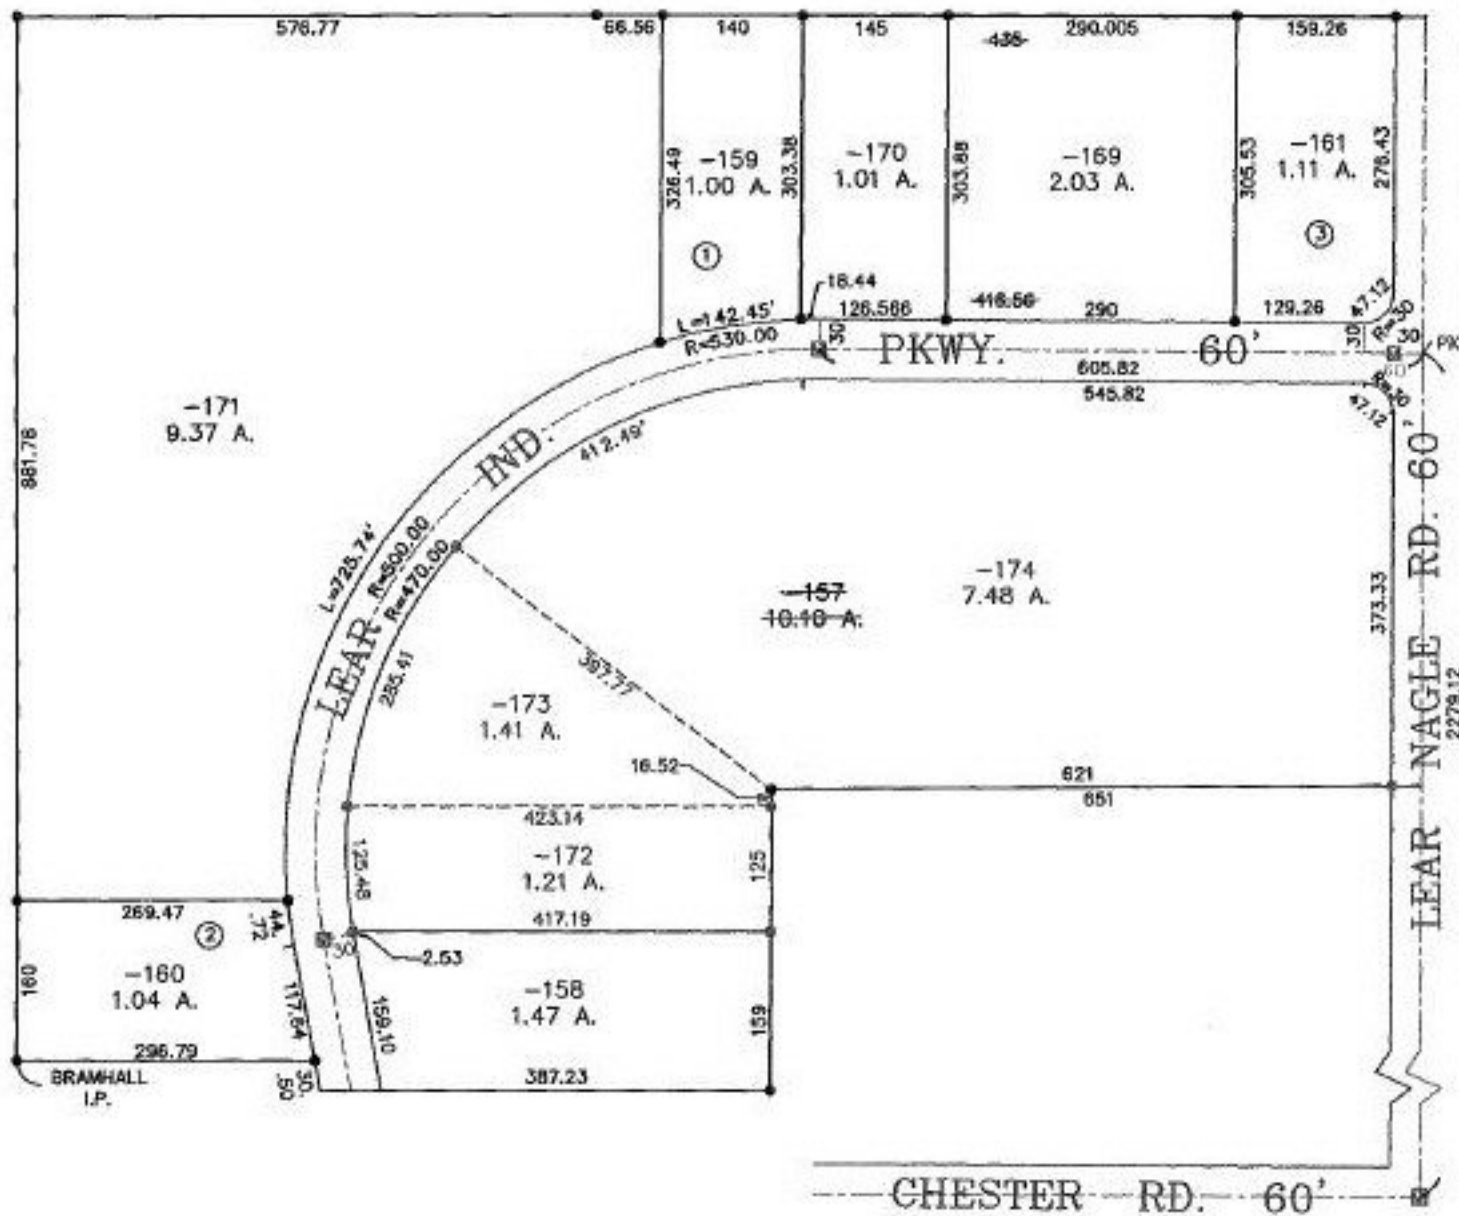

SPLITS/DEEDS PROCESSED
 LORAIN COUNTY TAX MAP DEPARTMENT
 226 MIDDLE AVE. ELYRIA, OHIO

SURVEYED BY: RICHARD A. THOMPSON, JR.
 CLOSURE: 0.05 : 10.000
 MAP PAGE(S): 4-G
 APPROVED BY: TJS DATE: 04/07/99
 SCALE: 1" = 200' PRIOR INSTRUMENT: CR 1303/813