


PARENT PARCEL: 10-00-020-103-085

CHILD PARCEL: 10-00-020-103-086 & 087

STARTING POINT: C/Ls OF HALE ROAD & HASTINGS ROAD

NO. 00050

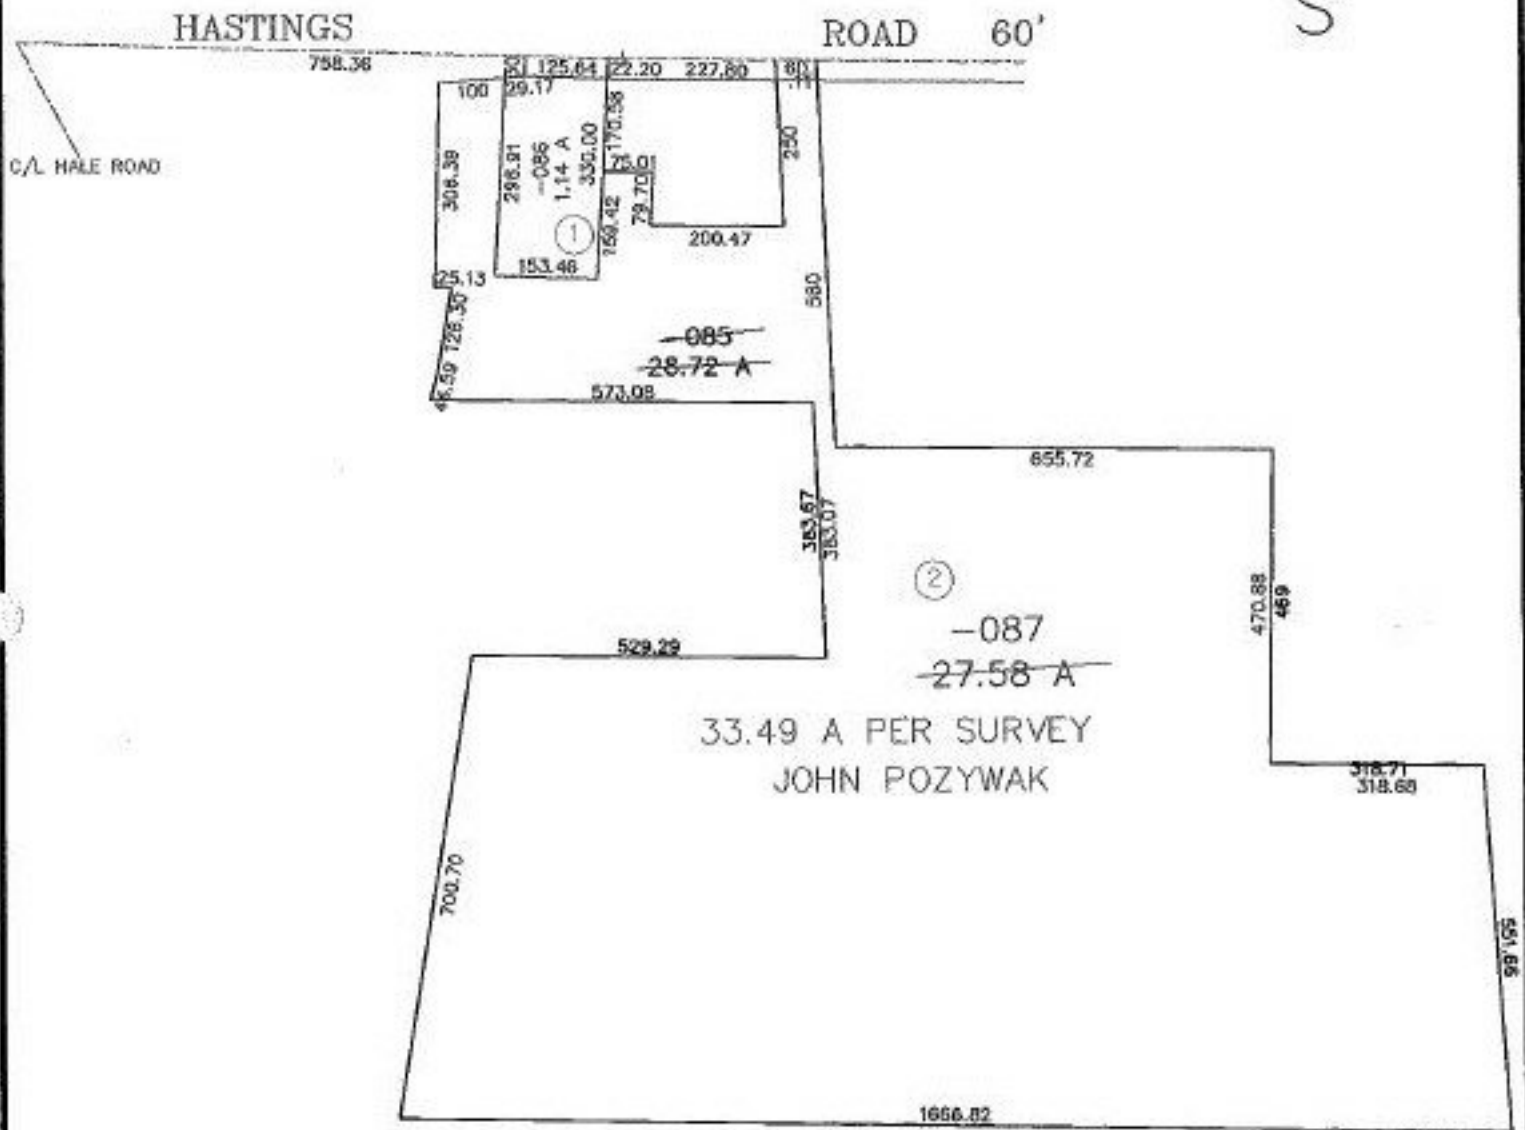

FS  
2-16-00



**SPLITS/DEEDS PROCESSED**  
LORAIN COUNTY TAX MAP DEPARTMENT  
226 MIDDLE AVE. ELYRIA, OHIO

SURVEYED BY: JOHN POZYWAK  
 CLOSURE: 0.70 / 10.000  
 MAP PAGE(S): 10-00-020-E & F  
 APPROVED BY: F. COLBERT DATE: 4/27/99  
 SCALE: 1" = 300' PRIOR INSTRUMENT: OR 779/469