

PARENT PARCEL: 18-00-007-000-004



CHILD PARCEL: 18-00-007-000-006 THRU -008

STARTING POINT: R.R.S., CL. OF HAWLEY RD. & CL. OF PECK WADSWORTH RD.

NO. 00058



HAWLEY RD. 60'

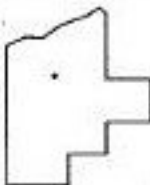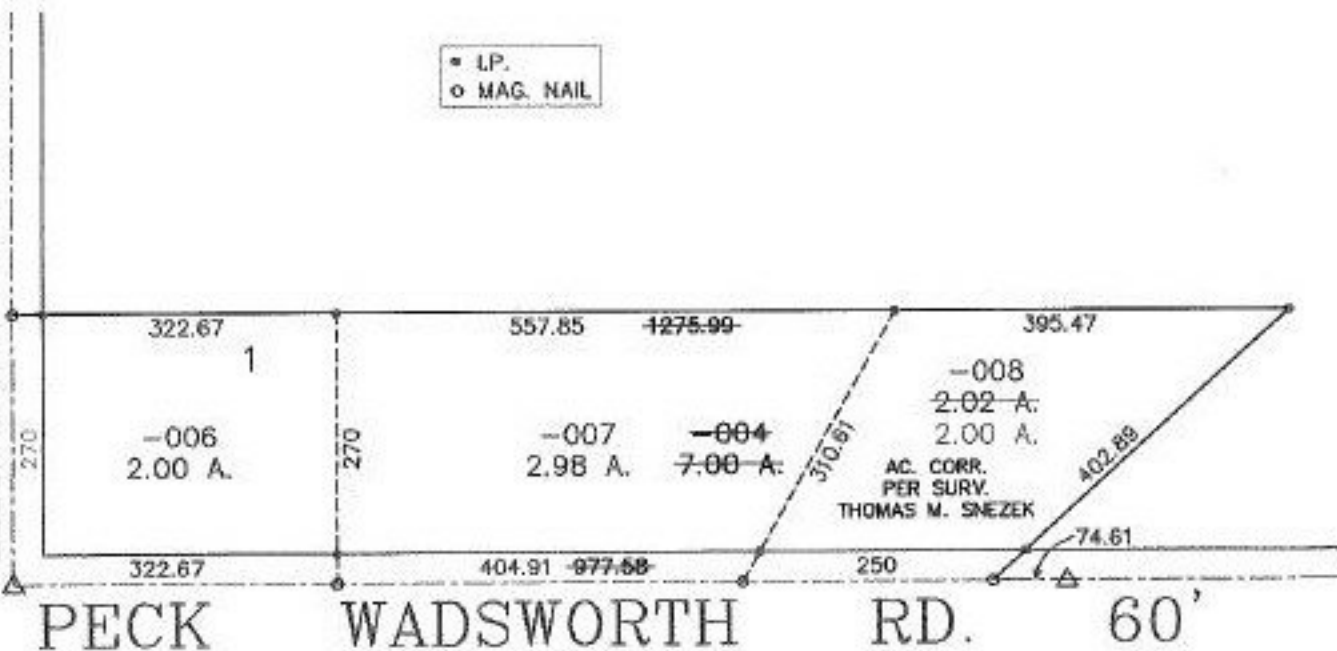

SPLITS/DEEDS PROCESSED
LORAIN COUNTY TAX MAP DEPARTMENT
226 MIDDLE AVE. ELYRIA, OHIO

SURVEYED BY: THOMAS M. SNEZEK
 CLOSURE: 0.04 : 10,000
 MAP PAGE(S): 18-D
 APPROVED BY: TJS DATE: 04/08/99
 SCALE: 1" = 200' PRIOR INSTRUMENT: 970507777