PARENT PARCEL: 10-00-008-116-014


CHILD PARCEL: SPLIT INTO 10-00-008-116-017 & -018 WITH SPLIT #21727

NO. 00060-D

STARTING POINT: CL OF MIDDLE AVE. & NORTH LINE OF O.L. 8


DEED CHECK

10-00-008-116-014 DESCRIPTION DOESN'T CLOSE

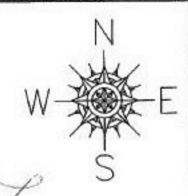

ALSO -014 WAS SPLIT INTO -017 & -018 SEE SPLIT # 21727

THTO COMB

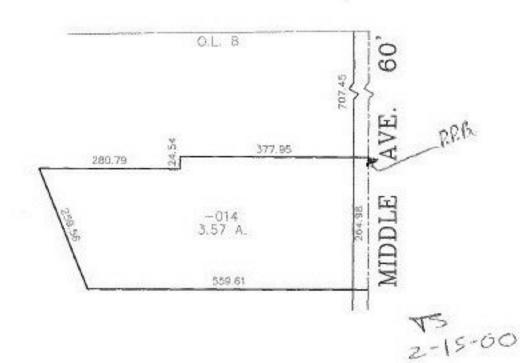

SPLITS/DEEDS PROCESSED

LORAIN COUNTY TAX MAP DEPARTMENT
226 MIDDLE AVE. ELYRIA, OHIO

SURVEYED BY: KS & ASSOC.

CLOSURE: 5.65 : 10,000

MAP PAGE(S): 10-00-008-D

APPROVED BY: IJS DATE: 05/06/99

SCALE: 1"= 200' PRIOR INSTRUMENT: OR 989/549