


PARENT PARCEL: 11-00-010-000-038

CHILD PARCEL: 11-00-010-000-053 & -054

STARTING POINT: MON. BOX, CL. OF SPRAGUE RD. & EAST LINE OF O.L. 10

NO. 00066

SPRAGUE RD. 60'

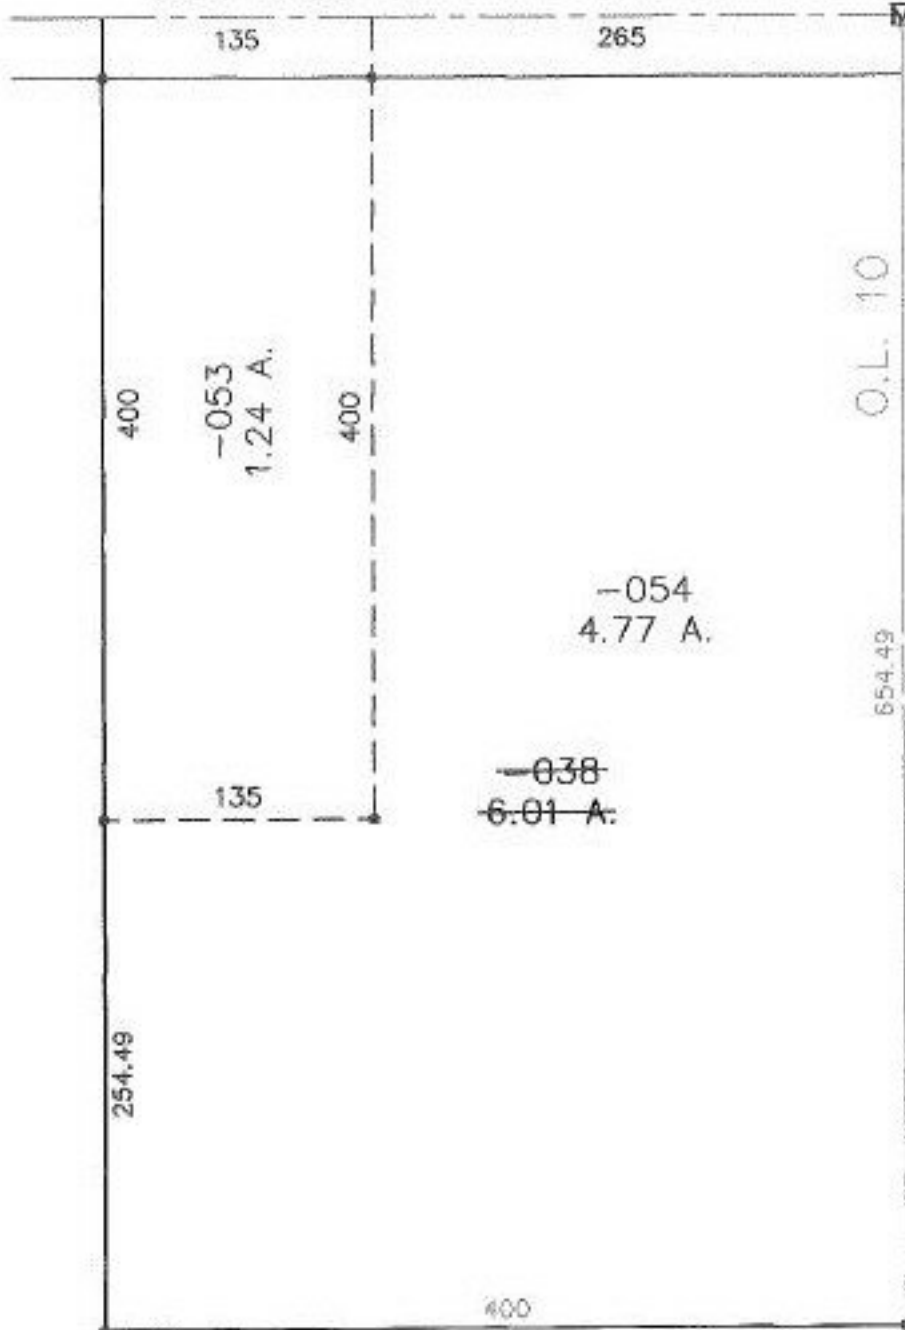

*Handwritten:* 13  
2-17-00



**SPLITS/DEEDS PROCESSED**

LORAIN COUNTY TAX MAP DEPARTMENT  
226 MIDDLE AVE. ELYRIA, OHIO

SURVEYED BY: JOHN POZYWAK  
 CLOSURE: 0.00 : 10.000  
 MAP PAGE(S): 11-00-010-B  
 APPROVED BY: TJS      DATE: 04/16/99  
 SCALE: 1" = 100'      PRIOR INSTRUMENT: GR 1425/971