


PARENT PARCEL: 05-00-051-000-009

CHILD PARCEL: 05-00-051-000-010 & -011

STARTING POINT: MON. BOX, CL. OF OBERLIN RD. & THE SOUTH LINE OF O.L. 51

NO. 00071

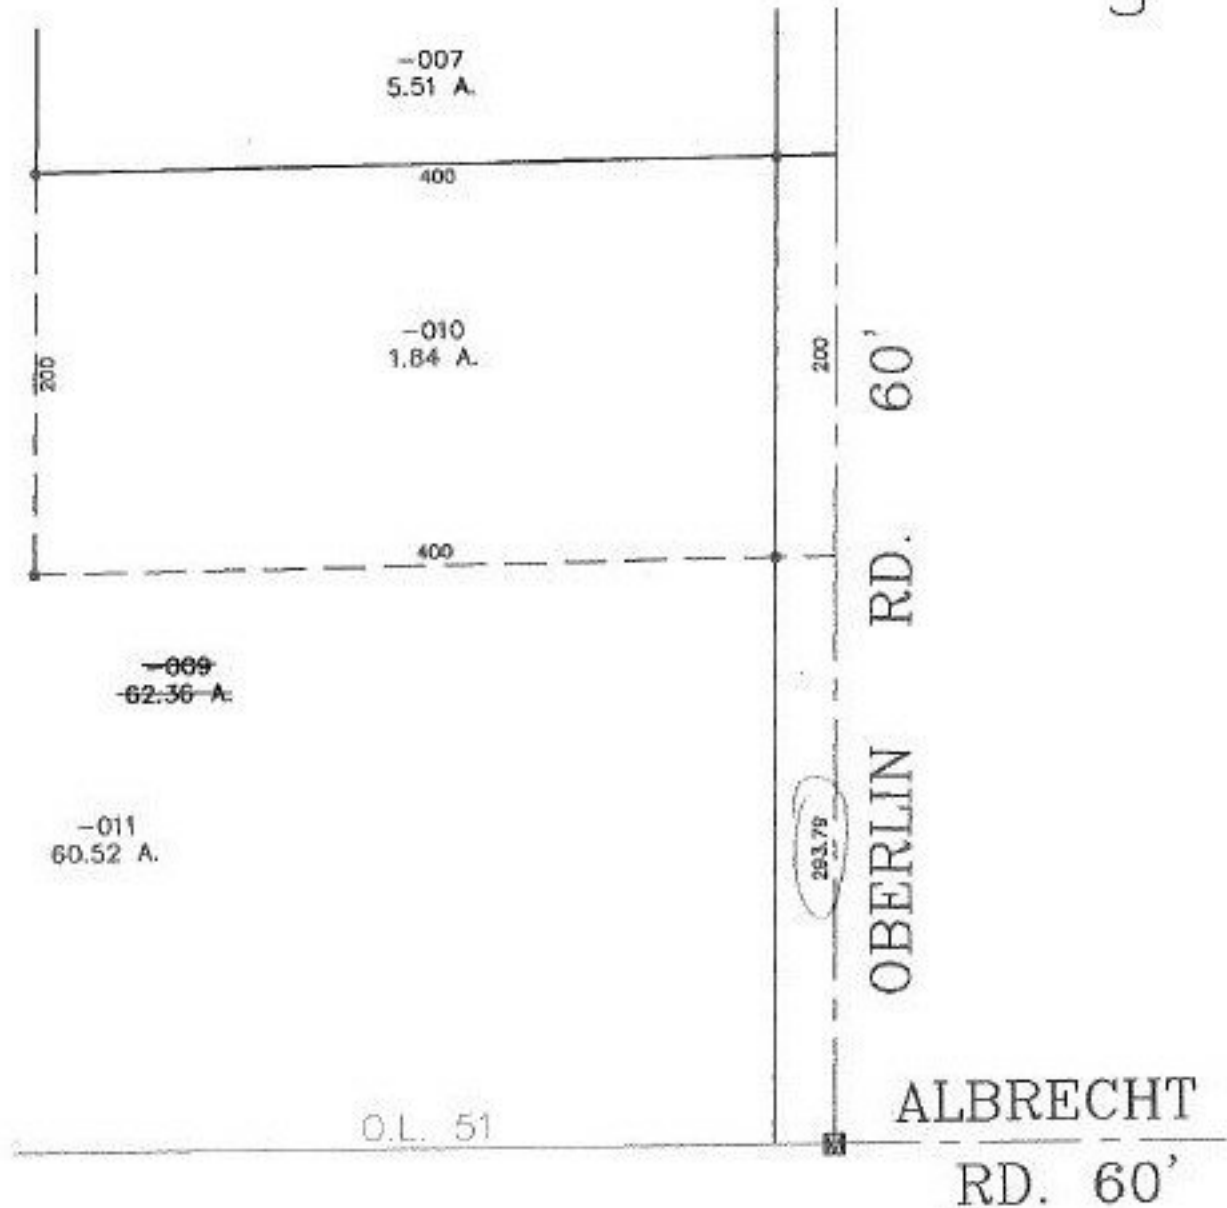

SPLITS/DEEDS PROCESSED

LORAIN COUNTY TAX MAP DEPARTMENT
226 MIDDLE AVE. ELYRIA, OHIO

SURVEYED BY: THOMAS A. SIMON

CLOSURE: 0.00 : 10.000

MAP PAGE(S): 5-G

APPROVED BY: IJS DATE: 04/23/99

SCALE: 1" = 100' PRIOR INSTRUMENT: OR 567/75