

PARENT PARCEL: 19-03-009-000-010

CHILD PARCEL: XX-XX-XXX-XXX-XXX


STARTING POINT: XXXXXX

NO. 00072-X


DROP FROM DUPLICATE

19-03-009-000-010

-BLDG.

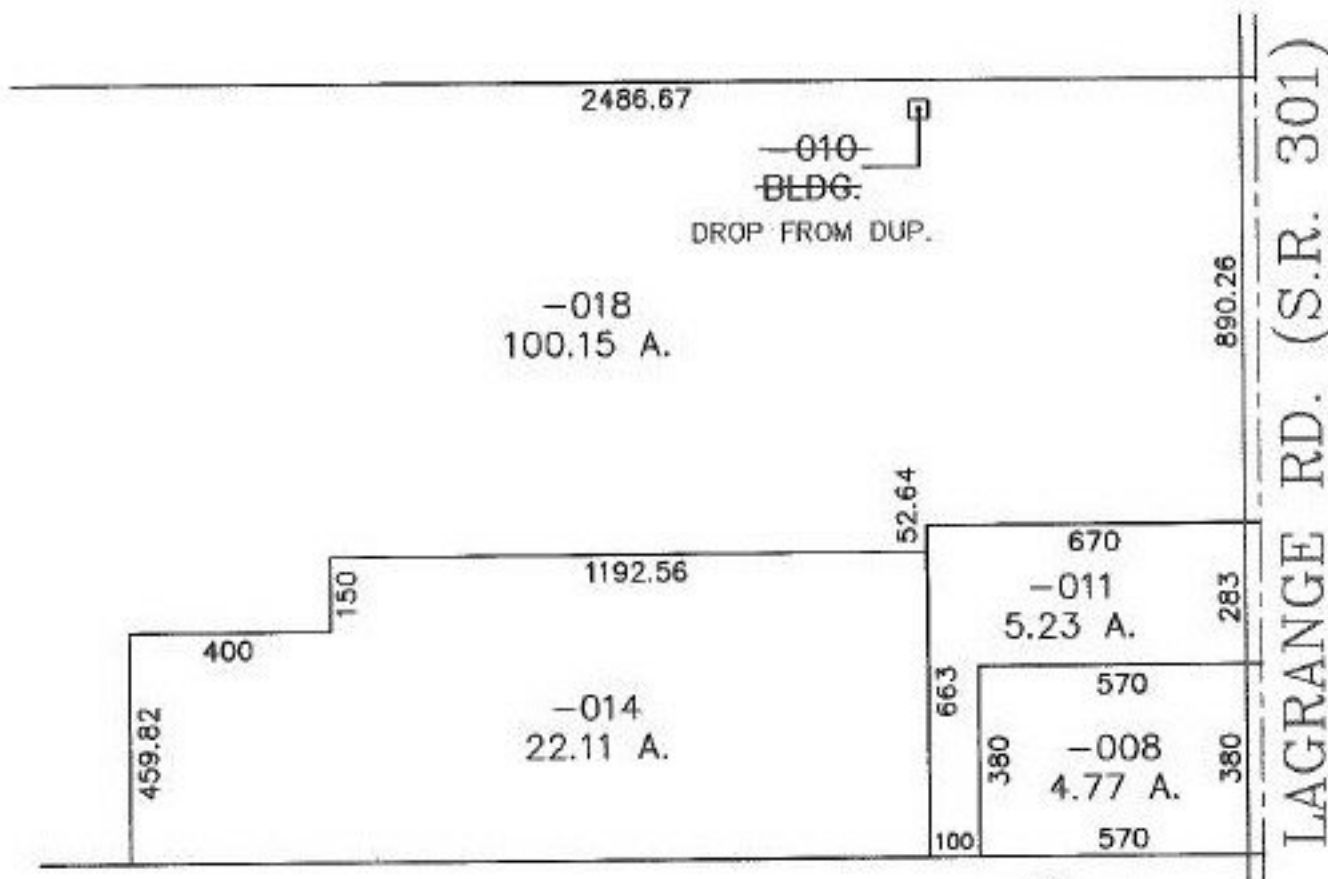

T3
4-6-00

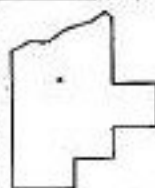

SPLITS/DEEDS PROCESSED

LORAIN COUNTY TAX MAP DEPARTMENT
226 MIDDLE AVE. ELYRIA, OHIO

SURVEYED BY: NONE

CLOSURE: NONE

MAP PAGE(S): 19-F

APPROVED BY: T. SPILLMAN DATE: 02/24/00

SCALE: 1" = 400' PRIOR INSTRUMENT: NONE