


PARENT PARCEL: 09-00-023-102-020

CHILD PARCEL: 09-00-023-102-027

STARTING POINT: MONUMENT BOX IN C/L OF PYLE-SOUTH AMHERST ROAD & RUSSIA ROAD

NO. 00072

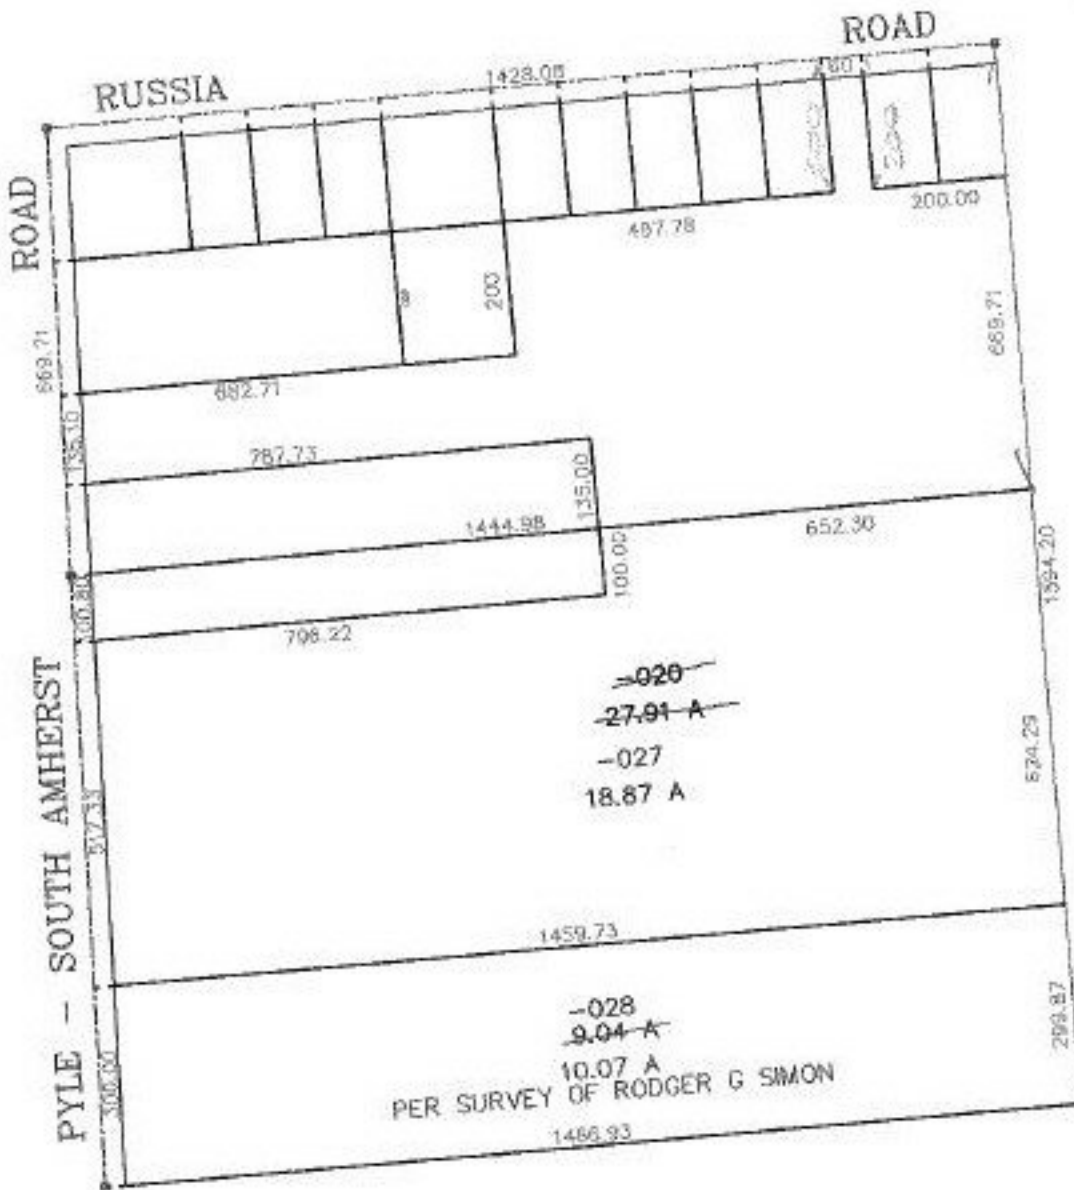

**SPLITS/DEEDS PROCESSED**  
**LORAIN COUNTY TAX MAP DEPARTMENT**  
 226 MIDDLE AVE. ELYRIA, OHIO

SURVEYED BY: RODGER G SIMON  
 CLOSURE: 0.02 / 10.000  
 MAP PAGE(S): 9-00-023-B  
 APPROVED BY: F. COLBERT DATE: 4/23/99  
 SCALE: 1" = 300' PRIOR INSTRUMENT: 1246/688