

PARENT PARCEL: 18-00-027-114-027, -045, & -046

CHILD PARCEL: XXXXXXXXXXXX



STARTING POINT: S.E. CORNER OF S\ 27 IN ORIGINAL VILLAGE PLAT

NO. 00075-X

MAP CORRECTION

PUT NEW DRAWING ON MYLAR

MYLAR DRAWN INCORRECTLY

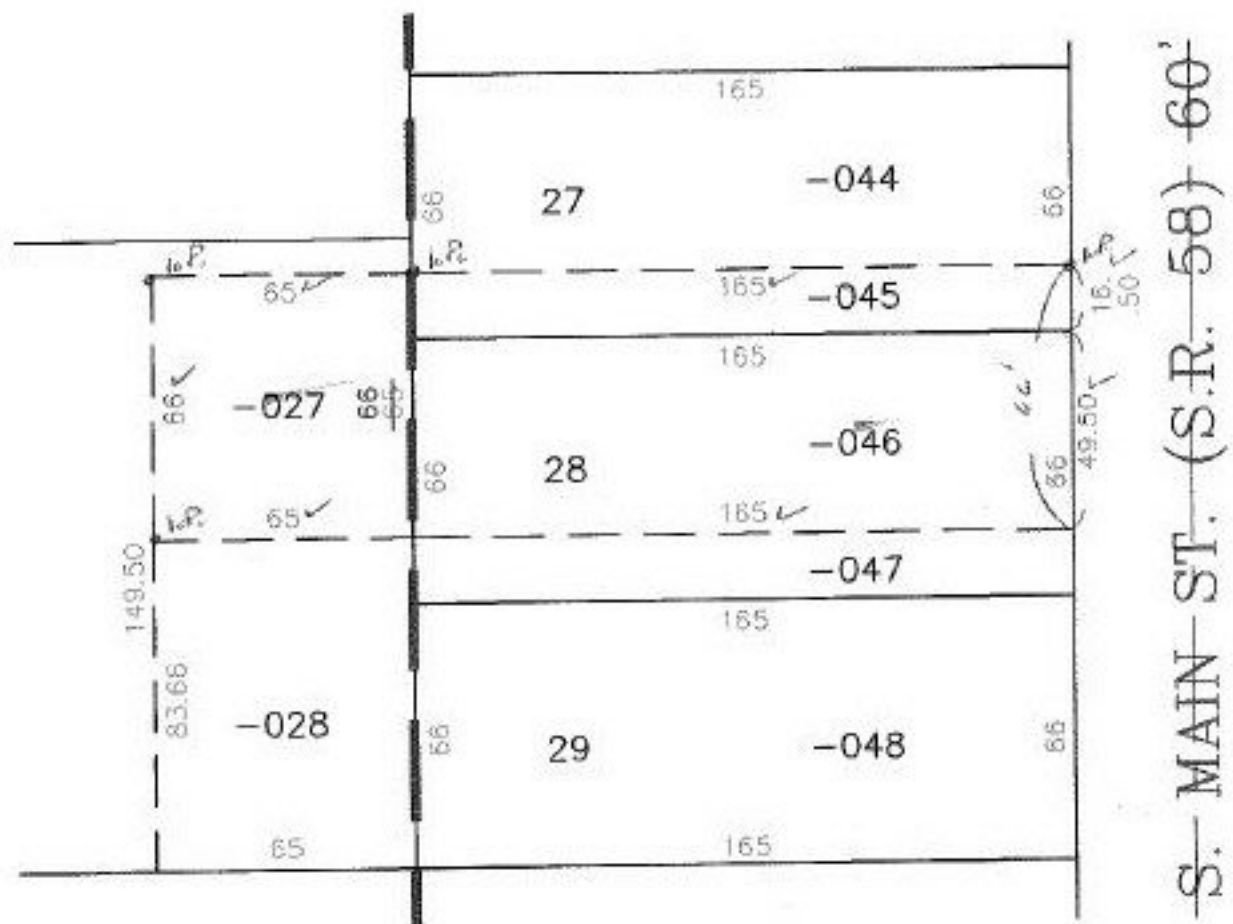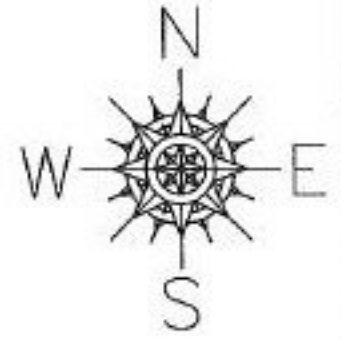

TJS
2-23-00



SPLITS/DEEDS PROCESSED
LORAIN COUNTY TAX MAP DEPARTMENT
 226 MIDDLE AVE. ELYRIA, OHIO

SURVEYED BY: J.W. WARDEN
 CLOSURE: 0.00 : 10.000
 MAP PAGE(S): 18-00-027-D
 APPROVED BY: TJS DATE: 06/23/99
 SCALE: 1" = 50' PRIOR INSTRUMENT: OR 1309/125