


652.61

SEE 9-00-099-B

09-00-098-000-017
0.10 A.C.

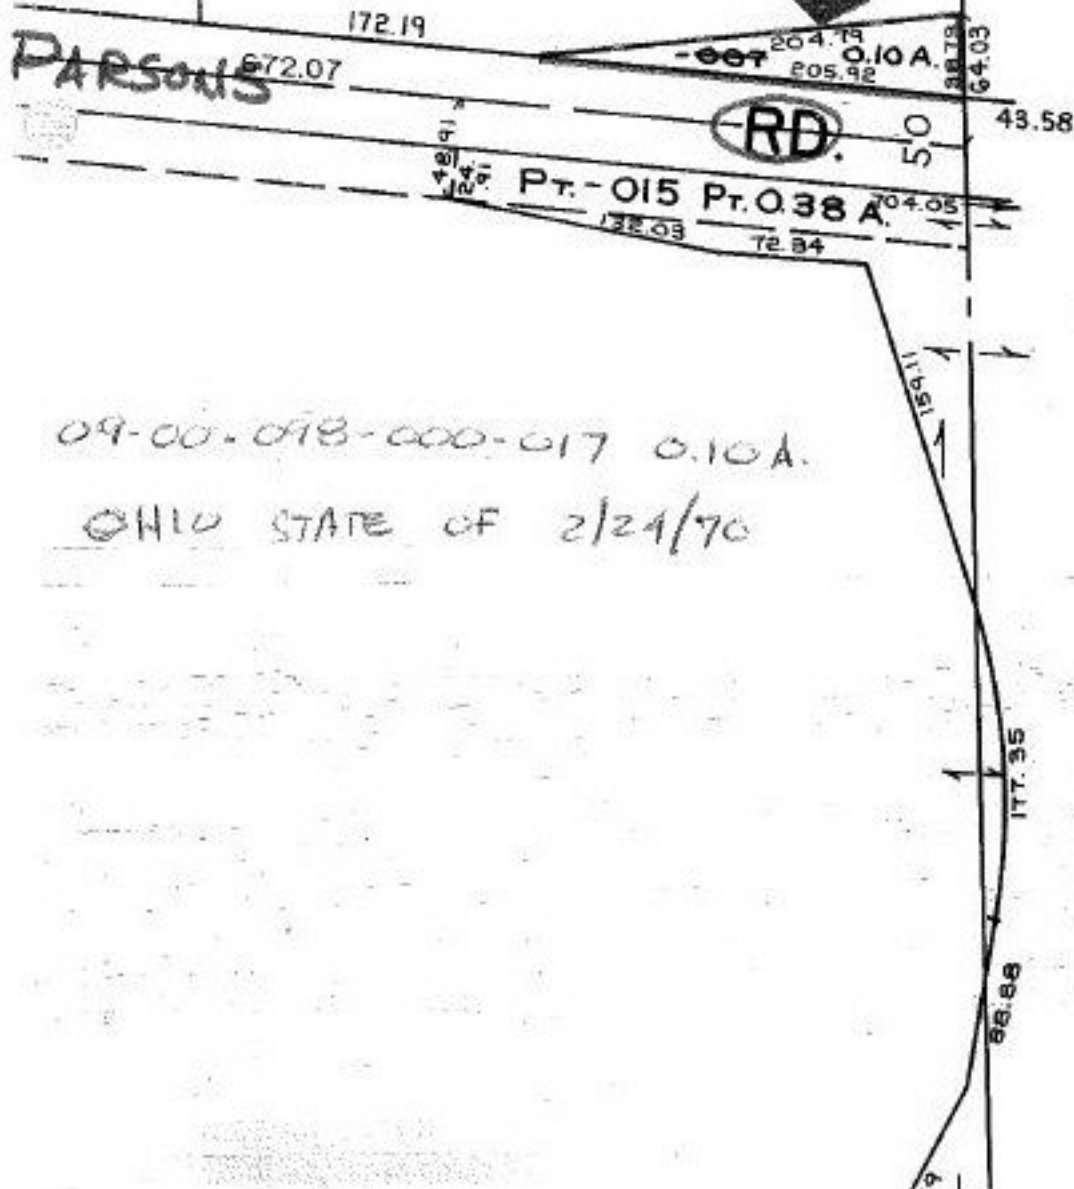

09-00-098-000-017 0.10 A.
OHIO STATE OF 2/24/70

MAP
CORRECTION

only
9900076-X

APPROVE
LORAIN CO
MAP DEPT.
DATE 2-8-99
DATE 12-14-99
FILE 9-00-098
BY DPH T.M.M.