

PARENT PARCEL: XXXXXXXXXXXXXXXX

CHILD PARCEL: XXXXXXXXXXXXXXXX

STARTING POINT: XXXXXX


NO. 00076-X

MAP CORRECTION ONLY

-09-00-002-000-001

GOOD NUMBER

05-00-091-106-012

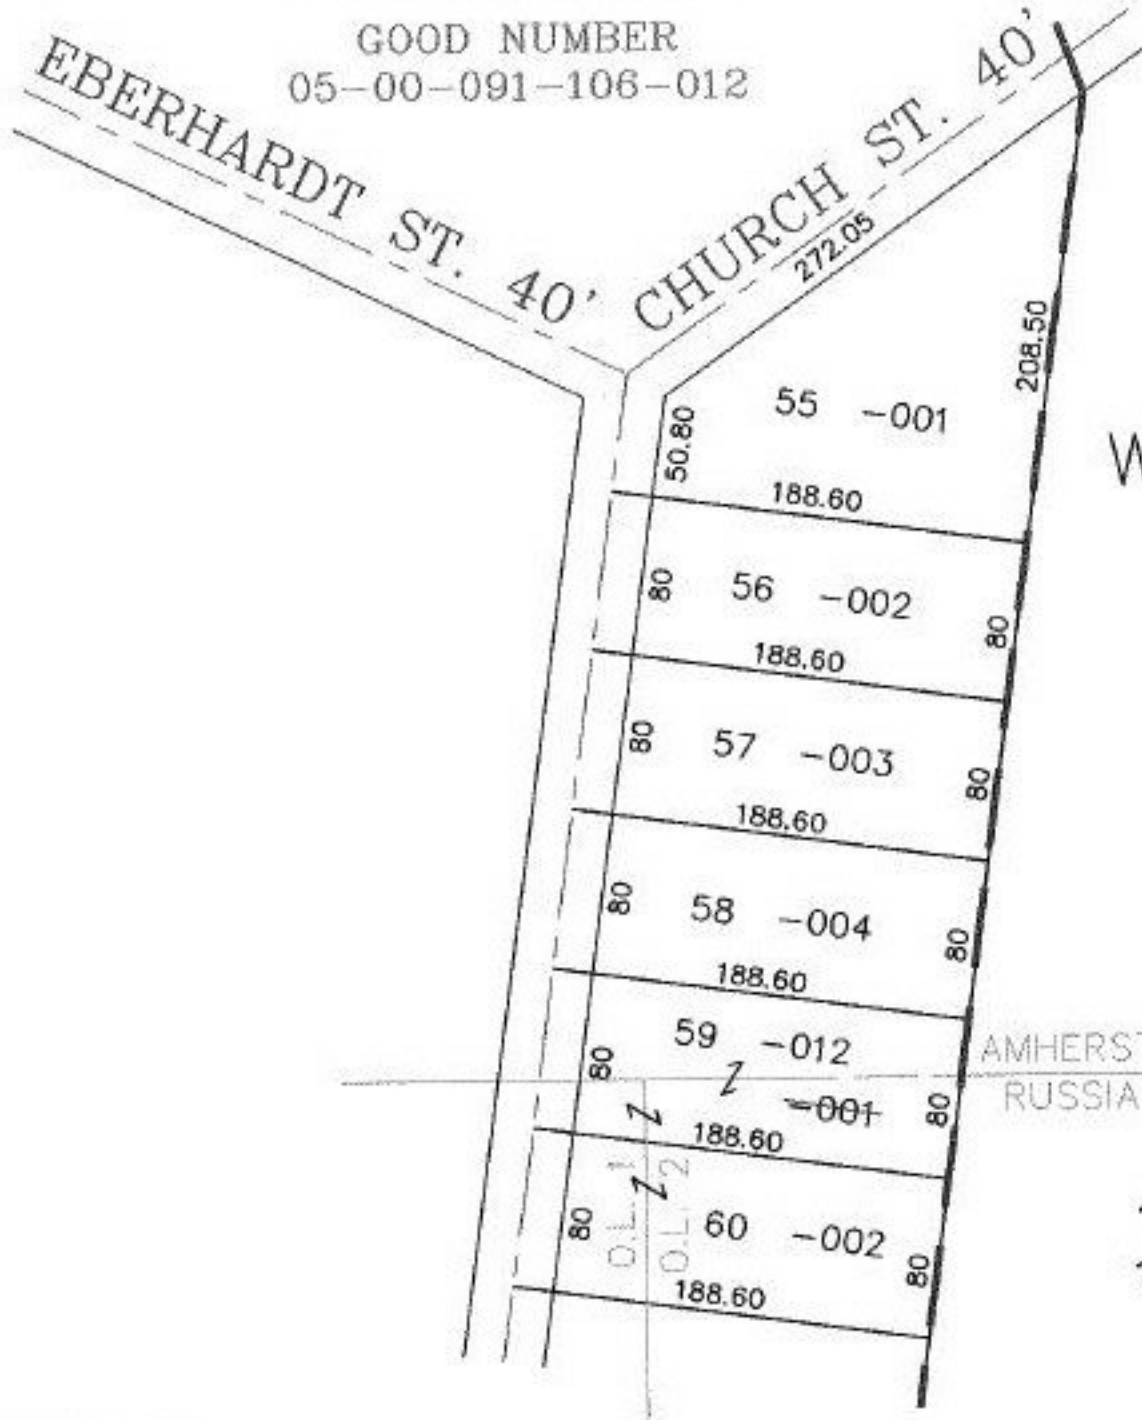

AMHERST TWP. O.L. 91
RUSSIA TWP. O.L. 2

TS
3-31-00

1 OF 2

SPLITS/DEEDS PROCESSED

LORAIN COUNTY TAX MAP DEPARTMENT
226 MIDDLE AVE. ELYRIA, OHIO

SURVEYED BY: NONE

CLOSURE: NA

MAP PAGE(S): 09-00-001-A & B & 05-00-091-B

APPROVED BY: T. McNAIR DATE: 12/14/99

SCALE: 1" = 100' PRIOR INSTRUMENT: NONE