


PARENT PARCEL: 01-00-073-000-019

CHILD PARCEL: 01-00-073-000-020 & -021

STARTING POINT: I.P., CL OF STICK RD. & WEST LINE OF O.L. 73

NO. 00076

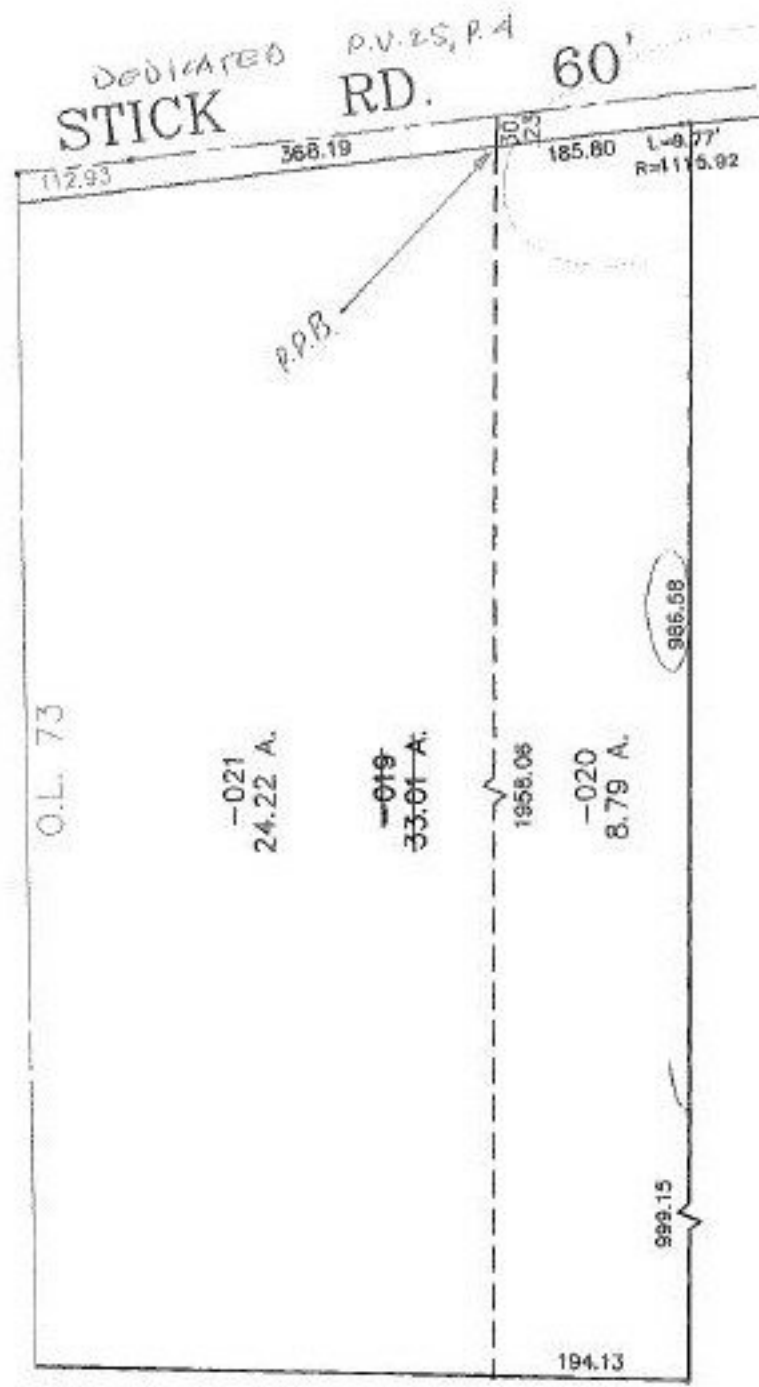

**SPLITS/DEEDS PROCESSED**  
**LORAIN COUNTY TAX MAP DEPARTMENT**  
 226 MIDDLE AVE. ELYRIA, OHIO

SURVEYED BY: CHARLES P. WARYU  
 CLOSURE: 0.01 : 10,000  
 MAP PAGE(S): 01-00-073  
 APPROVED BY: TJS DATE: 04/26/99  
 SCALE: 1" = 200' PRIOR INSTRUMENT: OR 394/334