

PARENT PARCEL: 02-01-004-115-001

CHILD PARCEL: XX-XX-XXX-XXX-XXX

STARTING POINT: XXXXXX



NO. 00077-X

# FRONTAGE & DEPTH CORRECTION

02-01-004-115-001

~~480 X 162~~

470 X 325

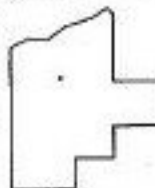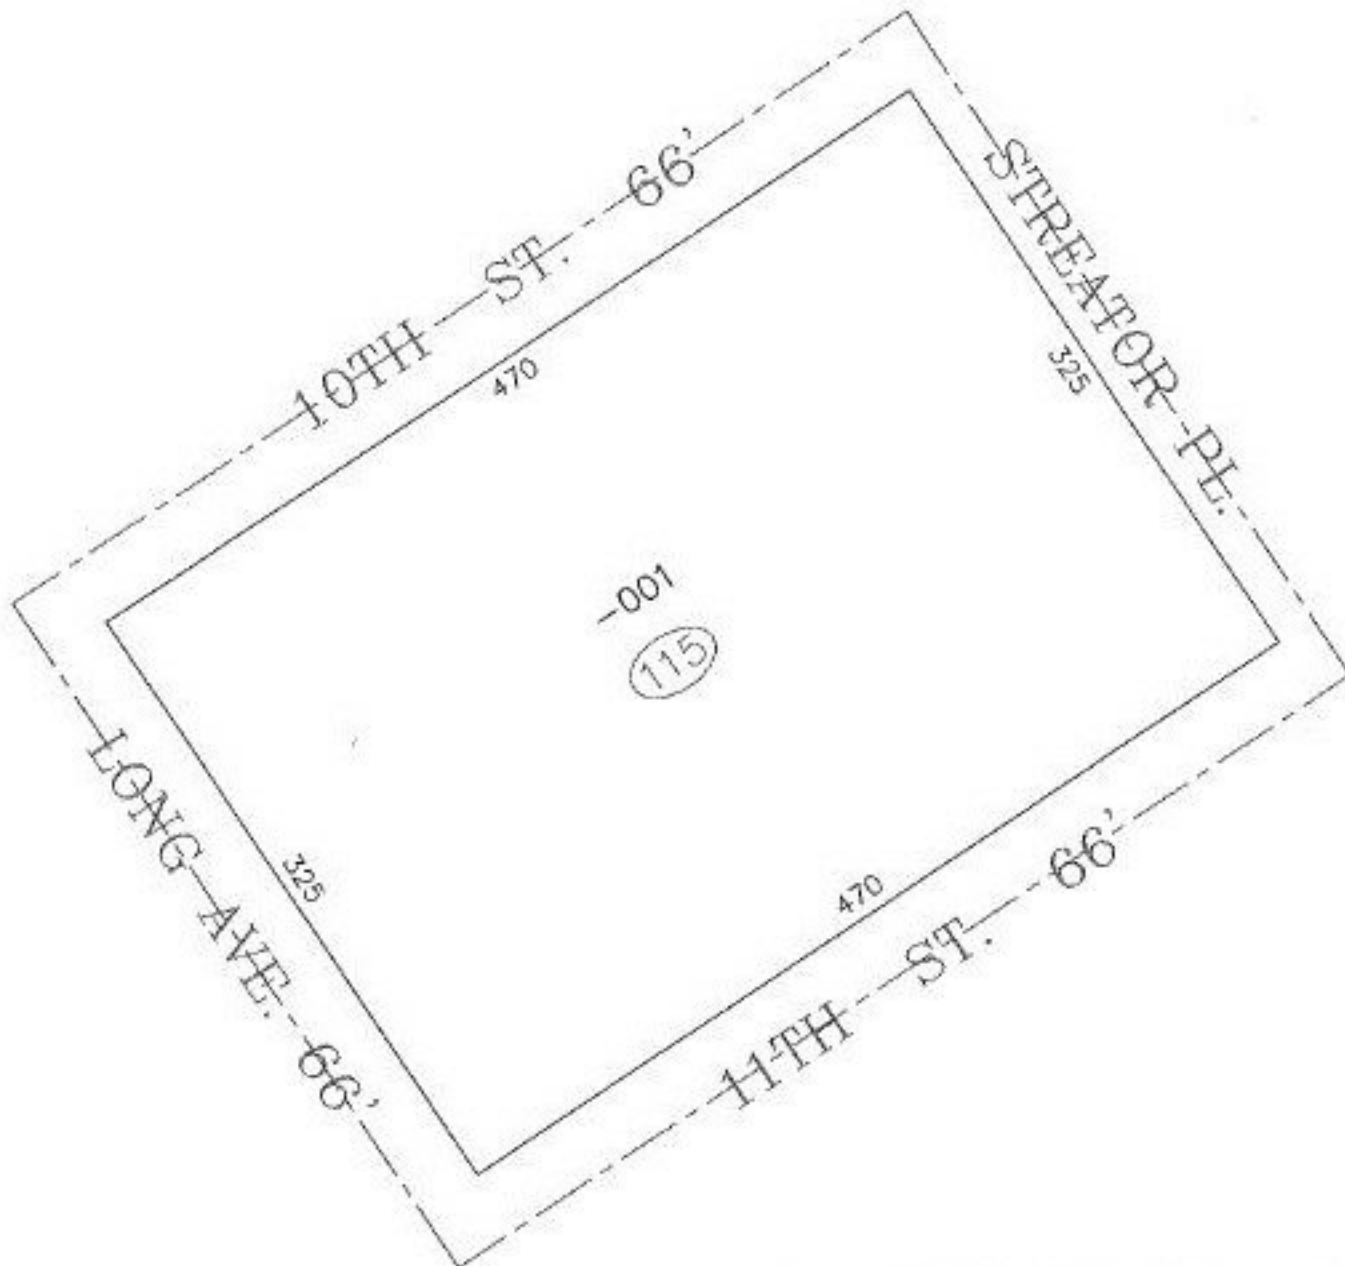

## SPLITS/DEEDS PROCESSED

LORAIN COUNTY TAX MAP DEPARTMENT  
226 MIDDLE AVE. ELYRIA, OHIO

SURVEYED BY: NONE

CLOSURE: 0.00 : 10.000

MAP PAGE(S): 02-01-004-B

APPROVED BY: TJS DATE: 06/22/99

SCALE: 1" = 100' PRIOR INSTRUMENT: NONE