

#00077


PARENT PARCEL: 05-00-063-101-100, -102, -164, & -176
CHILD PARCEL: 05-00-063-101-188 THRU -194
STARTING POINT: CL OF RUSTIC HILL LANE & CL OF ALLENDALE DR.

NO. 00077


RUSTIC HILL LN. 60'



DETAIL
NO SCALE

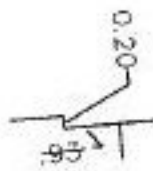

ALLENDALE DR. 60'

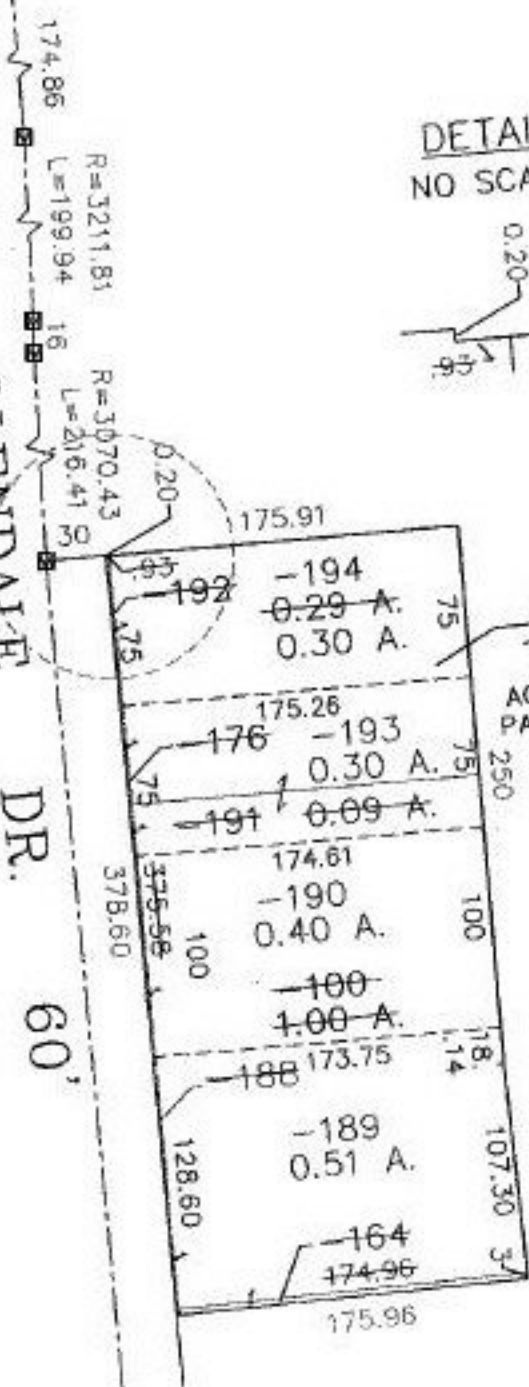

AC. CORR. PER SURV.
PATRICK A. MCGANNON

SPLITS/DEEDS PROCESSED

LORAIN COUNTY TAX MAP DEPARTMENT
226 MIDDLE AVE. ELYRIA, OHIO

SURVEYED BY: PATRICK A. MCGANNON
CLOSURE: 0.15 : 10.000
MAP PAGE(S): 05-00-063-A
APPROVED BY: TJS DATE: 04/27/99
SCALE: 1" = 100' PRIOR INSTRUMENT: 980582466