


PARENT PARCEL: 18-00-038-000-015, 18-00-039-000-007, 027

CHILD PARCEL: 18-00-038-000-015 & 18-00-039-000-029

STARTING POINT: C/A PITTS ROAD & SOUTH LINE OF O. L. 39

NO. 00080

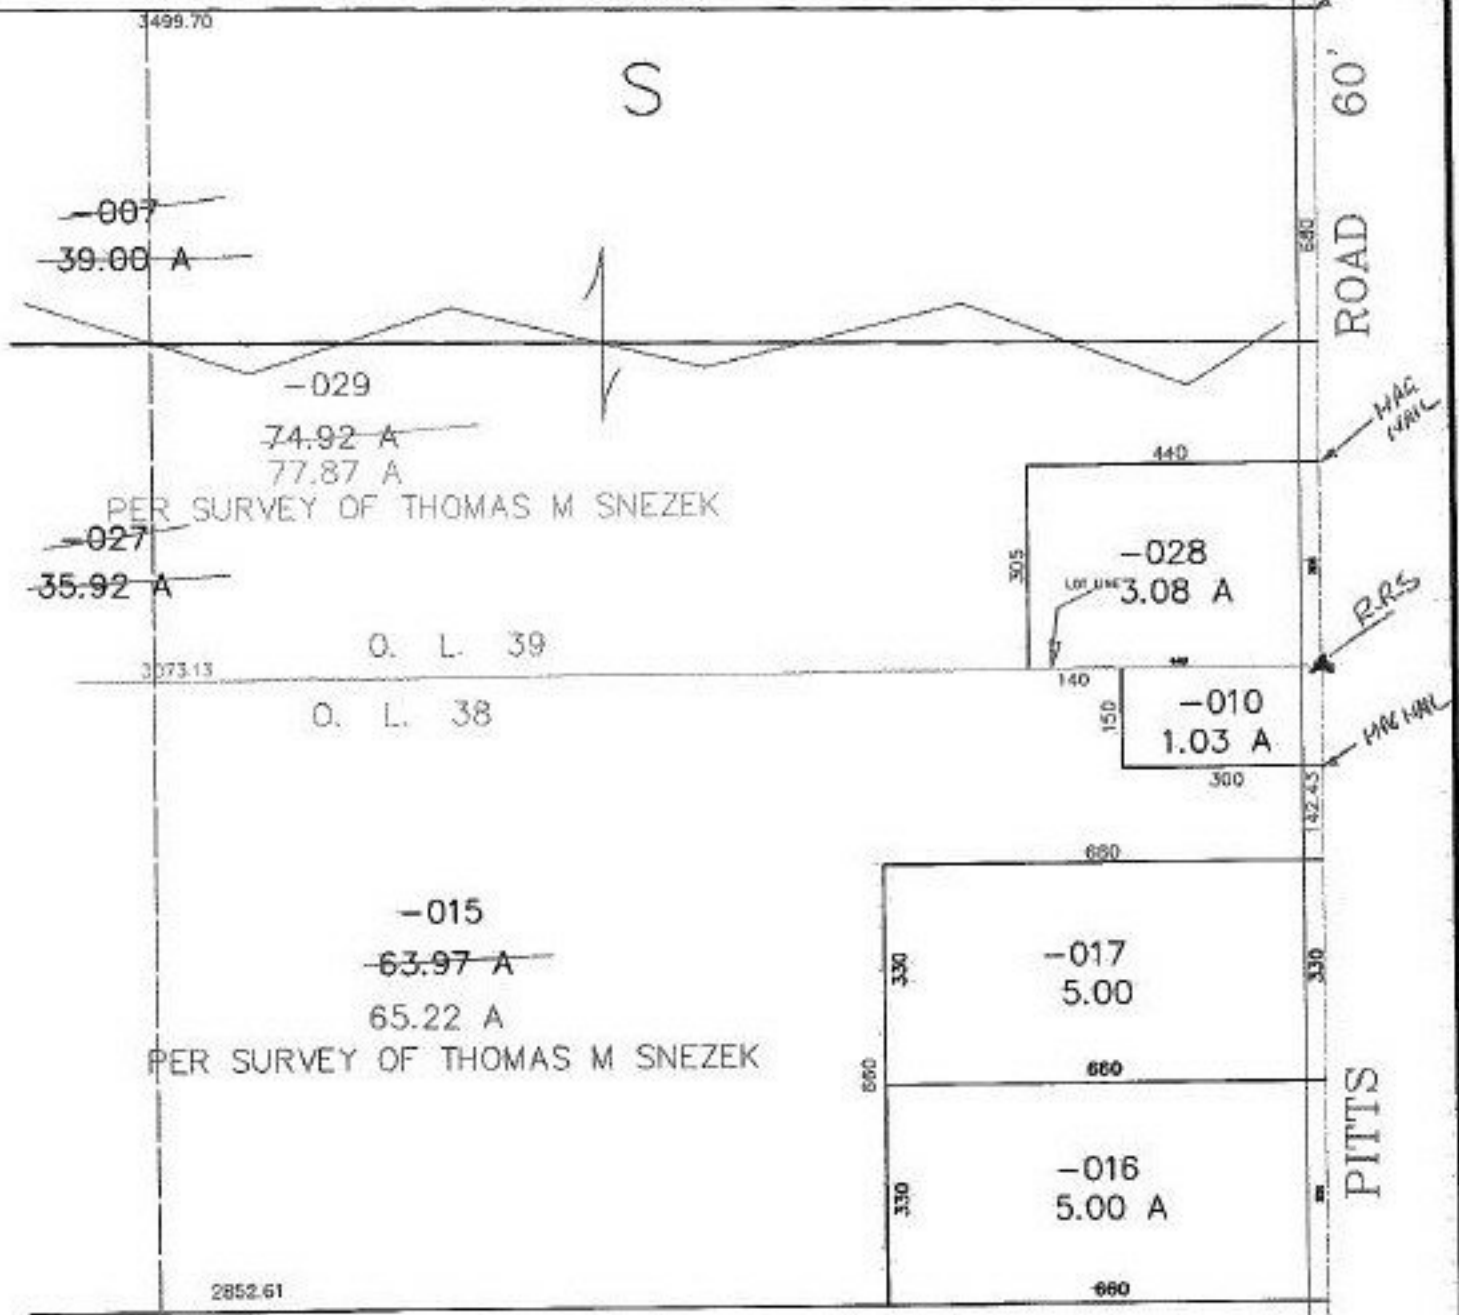

SHEET (2) OF (2)



SPLITS/DEEDS PROCESSED
LORAIN COUNTY TAX MAP DEPARTMENT
 226 MIDDLE AVE. ELYRIA, OHIO

SURVEYED BY: THOMAS M SNEZEK
 CLOSURE: 0.01 / 10,000
 MAP PAGE(S): 18-F
 APPROVED BY: F. COLBERT DATE: 4/22/99
 SCALE: 1" = 300' PRIOR INSTRUMENT: 113/816 111/816