


PARENT PARCEL: 18-00-038-000-015, 18-00-039-000-007, -027

CHILD PARCEL: 18-00-038-000-015 & 18-00-039-000-029

STARTING POINT: C/L OF PITTS ROAD & THE SOUTH LINE OF O. L. 39

NO. 00080

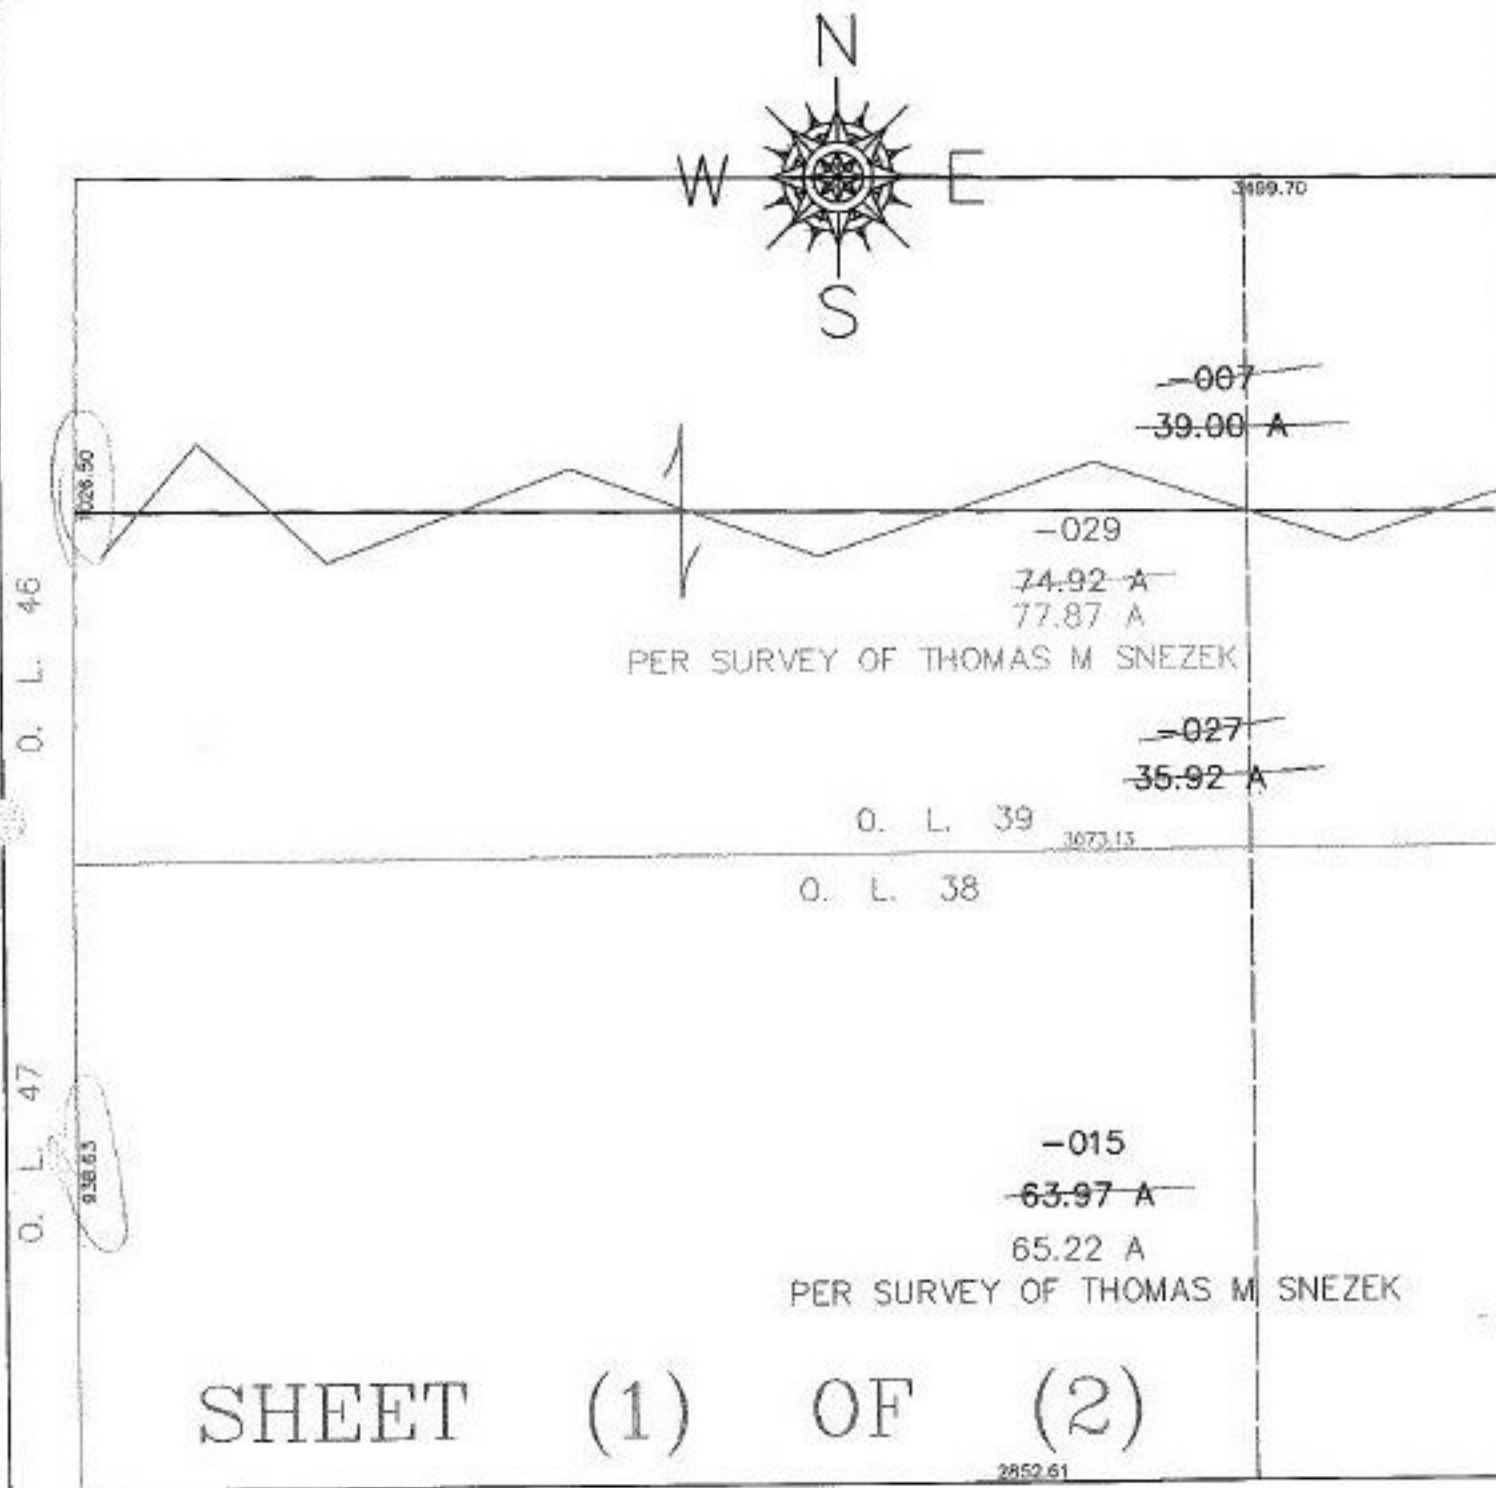

SHEET (1) OF (2)



SPLITS/DEEDS PROCESSED
LORAIN COUNTY TAX MAP DEPARTMENT
226 MIDDLE AVE. ELYRIA, OHIO

SURVEYED BY:	THOMAS M SNEZEK
CLOSURE:	0.01 / 10,000
MAP PAGE(S):	18-E
APPROVED BY:	F. COLBERT DATE: 4/22/99
SCALE:	1" = 300' PRIOR INSTRUMENT: 112/98, 108/98