

PARENT PARCEL: 04-00-027-102-034 & -035

CHILD PARCEL: XX-XX-XXX-XXX-XXX

STARTING POINT: CL OF N. RIDGE RD. & WEST LINE OF LAND CONVEYED TO EVENSON


NO. 00081-D

DEED CHECK



04-00-027-102-034 OK
1.87 A.

04-00-027-102-035 BEEN SPLIT
18.13 A. INTO PLAT
SEE PV 57, P. 20

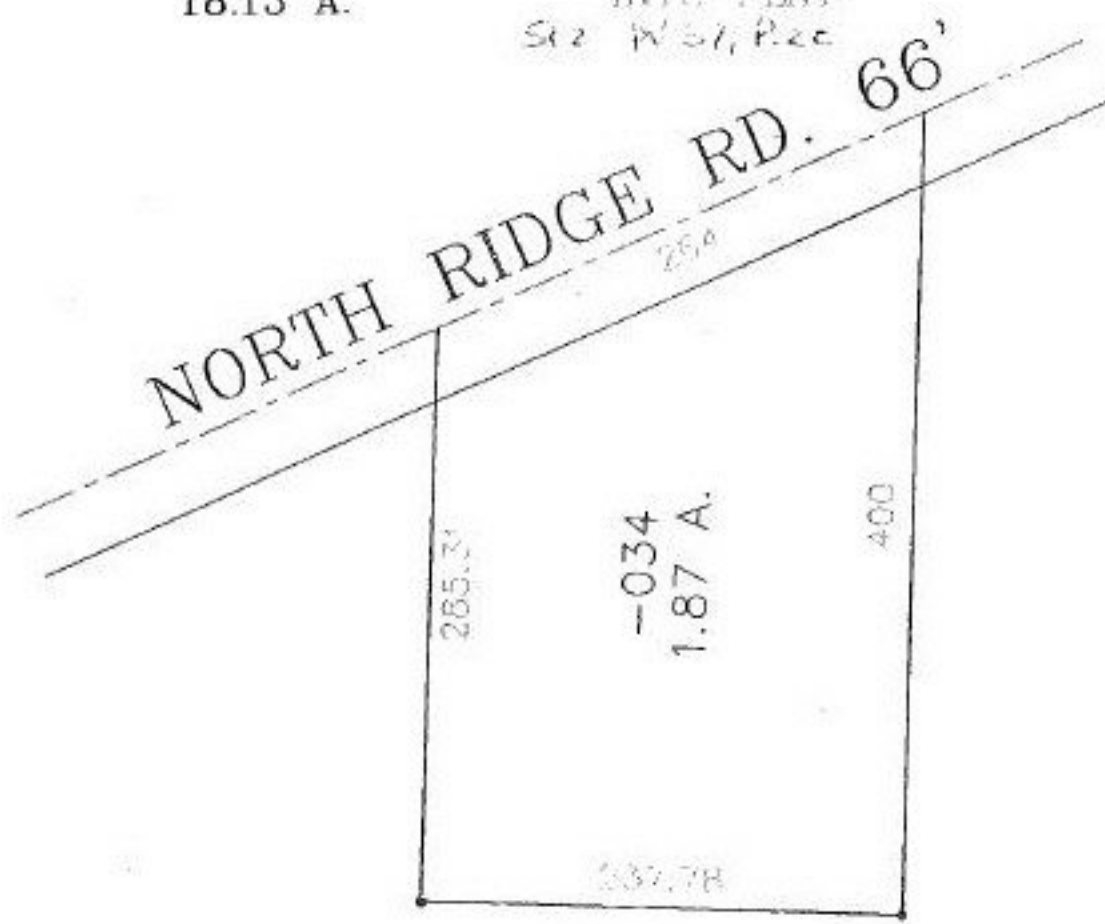

*-035 - INTO PLAT
SEE PV 57/P. 20*

SPLITS/DEEDS PROCESSED

LORAIN COUNTY TAX MAP DEPARTMENT
226 MIDDLE AVE. ELYRIA, OHIO

SURVEYED BY: RAY E. HOLLIS

CLOSURE: 0.05 : 10.000

MAP PAGE(S): 04-00-027-G

APPROVED BY: TJS DATE: 06/23/99

SCALE: 1" = 100' PRIOR INSTRUMENT: OR 380/594