


PARENT PARCEL: 09-00-023-102-022 & 028

CHILD PARCEL: 09-00-023-102-022 & 028

STARTING POINT: MONUMENT BOX IN C/L OF PYLE-SOUTH AMHERST ROAD & RUSSIA ROAD

NO. 00082

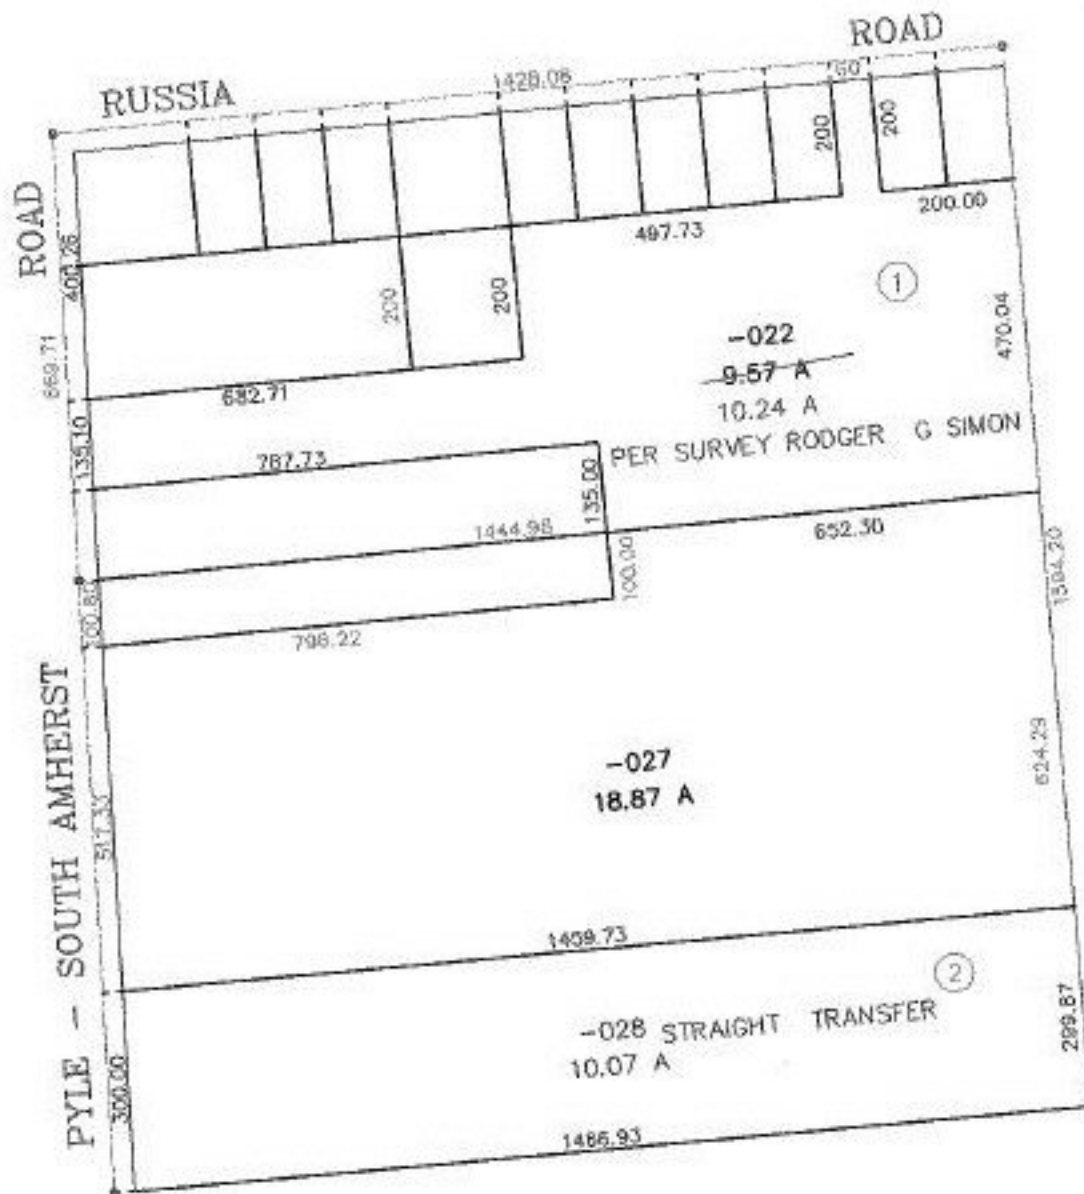

SPLITS/DEEDS PROCESSED
LORAIN COUNTY TAX MAP DEPARTMENT
 226 MIDDLE AVE. ELYRIA, OHIO

SURVEYED BY: RODGER G SIMON
 CLOSURE: 0.02 / 10.000
 MAP PAGE(S): 9-00-023-B
 APPROVED BY: F. COLBERT DATE: 4/23/99
 SCALE: 1" = 300' PRIOR INSTRUMENT: 1246/688