

PARENT PARCEL: 16-00-091-000-017

CHILD PARCEL: XX-XX-XXX-XXX-XXX

STARTING POINT: STONE IN THE CL OF ERHART & WEST LINE OF HAMM ESTATE


NO. 00085-D

# DEED CHECK

16-00-091-000-017

PARCEL HAS FRONTAGE  
ON ERHART RD.

SURVEY BEFORE NEXT TRANSFER

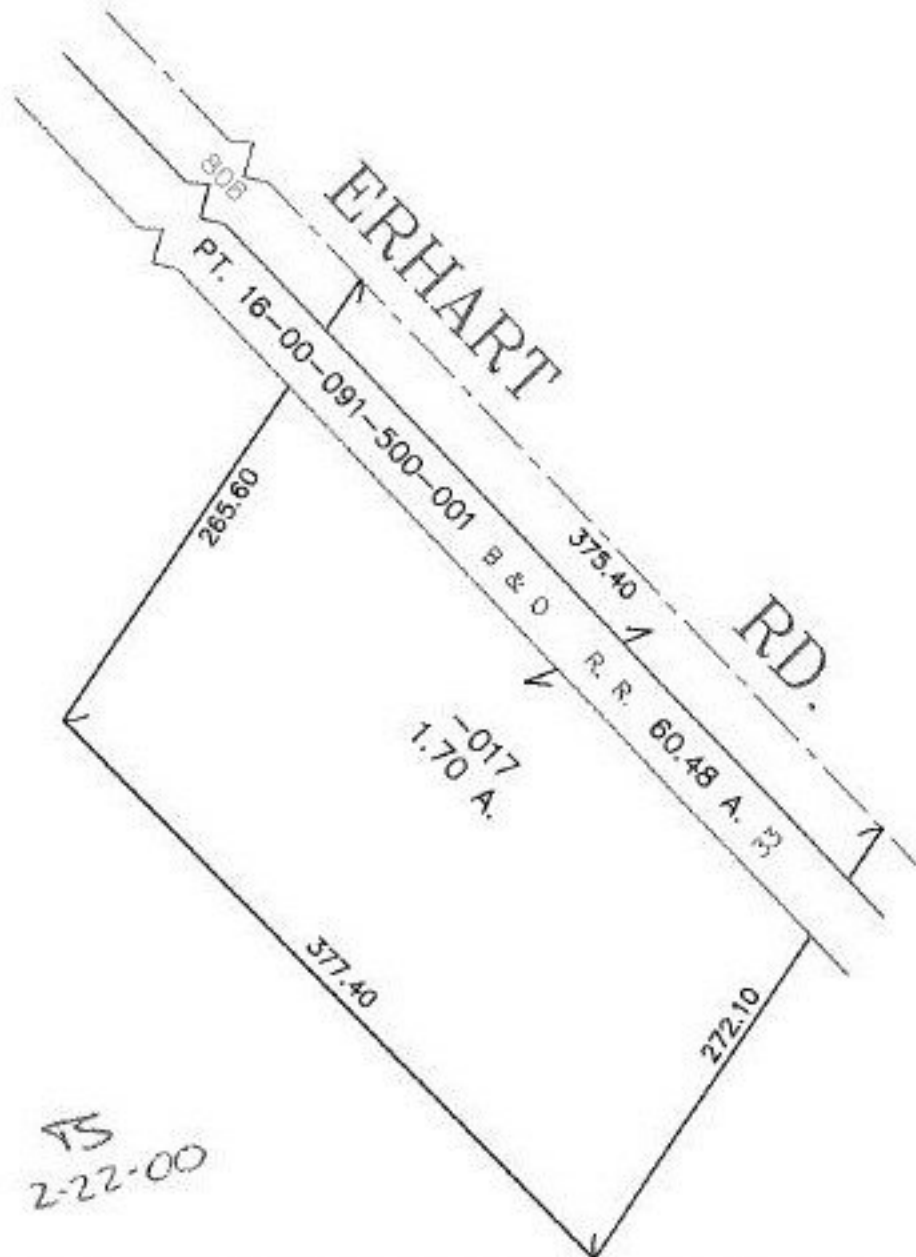

## SPLITS/DEEDS PROCESSED

LORAIN COUNTY TAX MAP DEPARTMENT  
226 MIDDLE AVE. ELYRIA, OHIO

SURVEYED BY: NONE

CLOSURE: 99.43 : 10.000

MAP PAGE(S): 16-00-091-B

APPROVED BY: TJS DATE: 06/28/99

SCALE: 1" = 100' PRIOR INSTRUMENT: OR 1456/218