

PARENT PARCEL: 01-00-056-000-003

CHILD PARCEL: XX-XX-XXX-XXX-XXX

STARTING POINT: CL OF RICE RD. & S.W. CORNER OF AN 8 ACRE PARCEL

NO. 00089-X

ACREAGE CORRECTION


01-00-056-000-003

~~1.11 A.~~

1.10 A.

CORR. PER DEED

DV 952/726

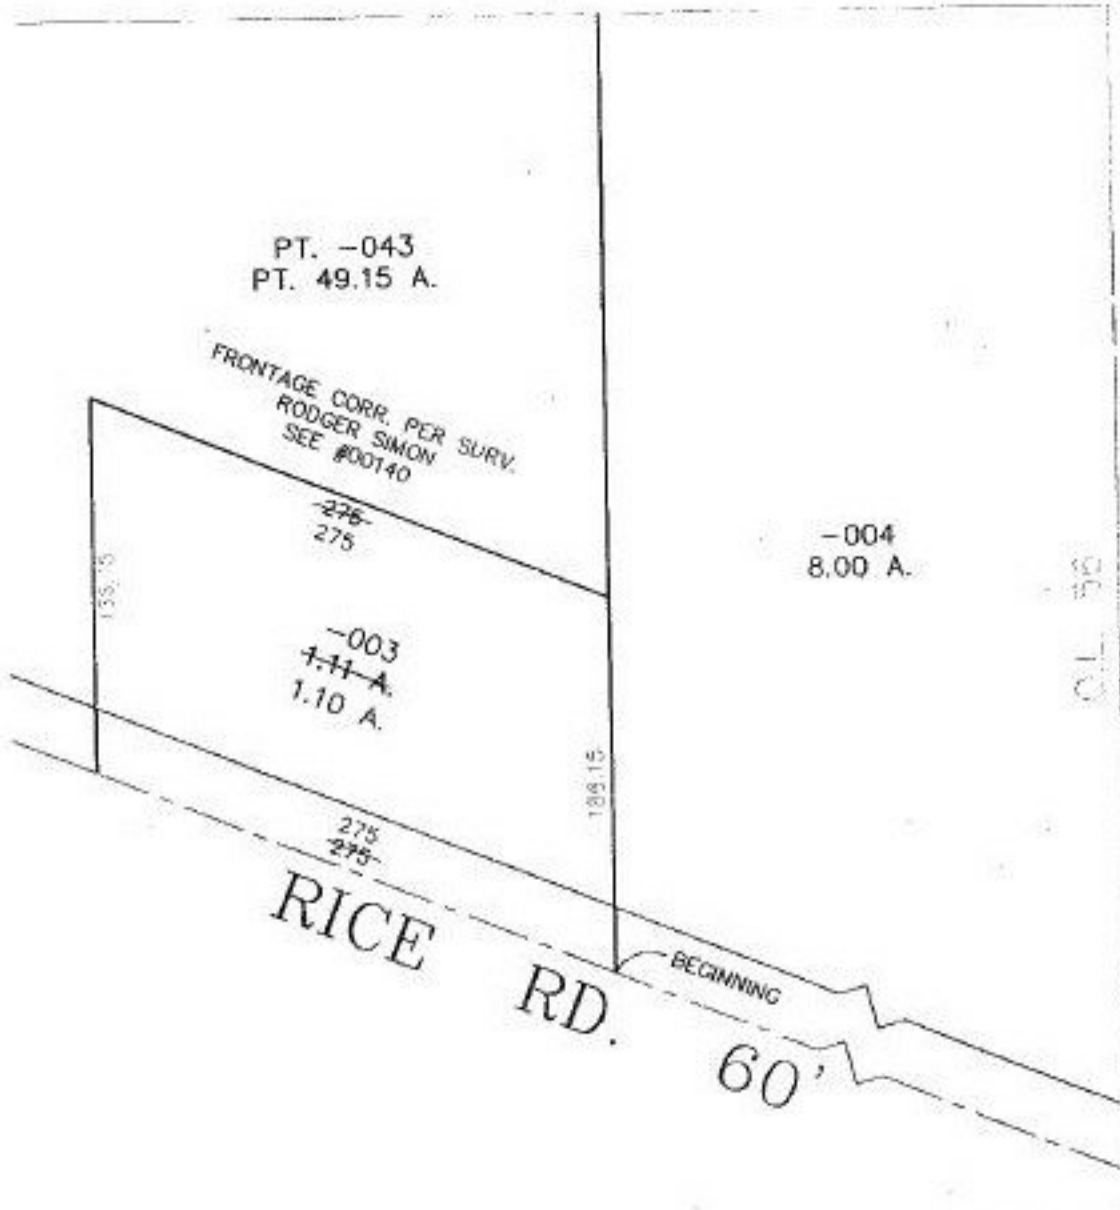

SPLITS/DEEDS PROCESSED

LORAIN COUNTY TAX MAP DEPARTMENT
226 MIDDLE AVE. ELYRIA, OHIO

SURVEYED BY: NONE

CLOSURE: CAN'T RUN

MAP PAGE(S): 1-1

APPROVED BY: TJS DATE: 06/28/99

SCALE: 1" = 100' PRIOR INSTRUMENT: DV 952/726