


PARENT PARCEL: 03-00-008-000-017

CHILD PARCEL: 03-00-008-000-024 & -025

STARTING POINT: MON. BOX, C.L. ABBE RD. & N.W. CORNER OF O.L. 8

NO. 00090

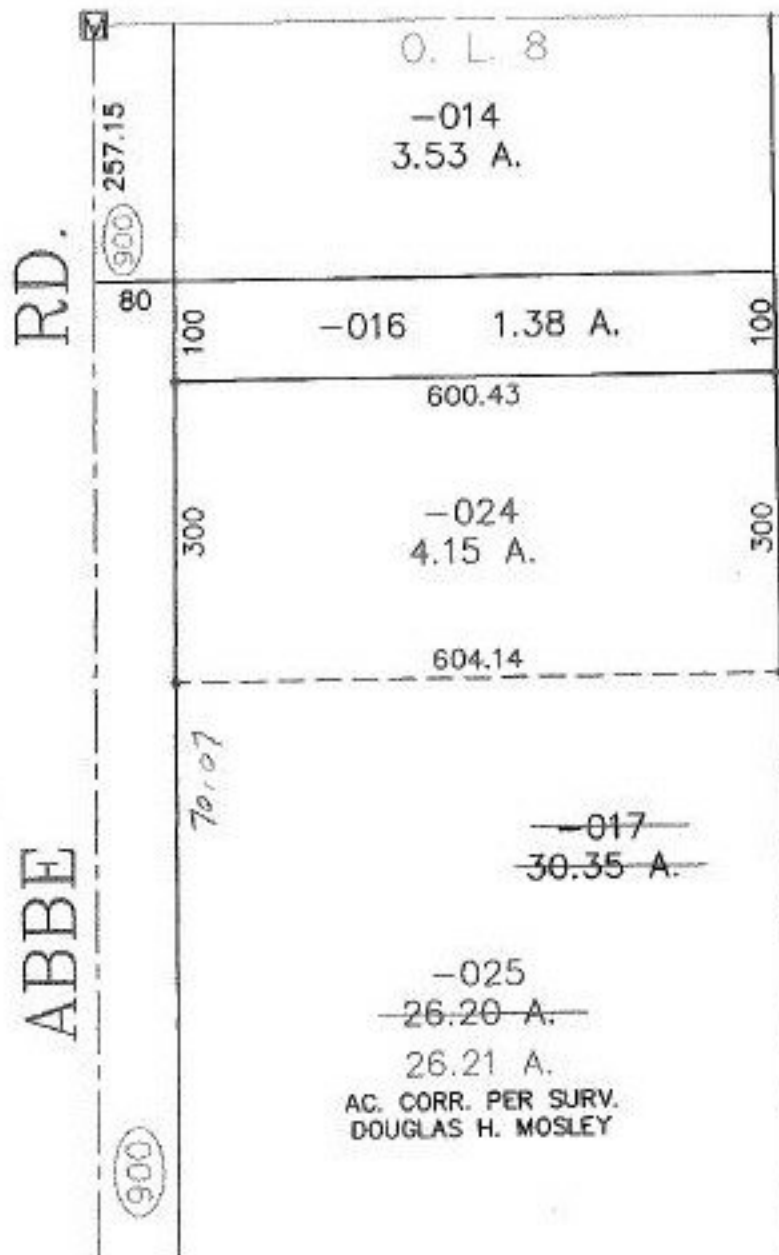

SPLITS/DEEDS PROCESSED
 LORAIN COUNTY TAX MAP DEPARTMENT
 226 MIDDLE AVE. ELYRIA, OHIO

SURVEYED BY: DOUGLAS H. MOSLEY
 CLOSURE: 0.17 : 10,000
 MAP PAGE(S): 03-00-008-A
 APPROVED BY: DRH DATE: 5/6/99
 SCALE: 1" = 200' PRIOR INSTRUMENT: OB 1208/758