


PARENT PARCEL: 11-00-046-000-002

CHILD PARCEL: XX-XX-XXX-XXX-XXX

STARTING POINT: CL OF S.R. 82 & CL OF S.R. 83

NO. 00091-D

ACREAGE CORRECTION

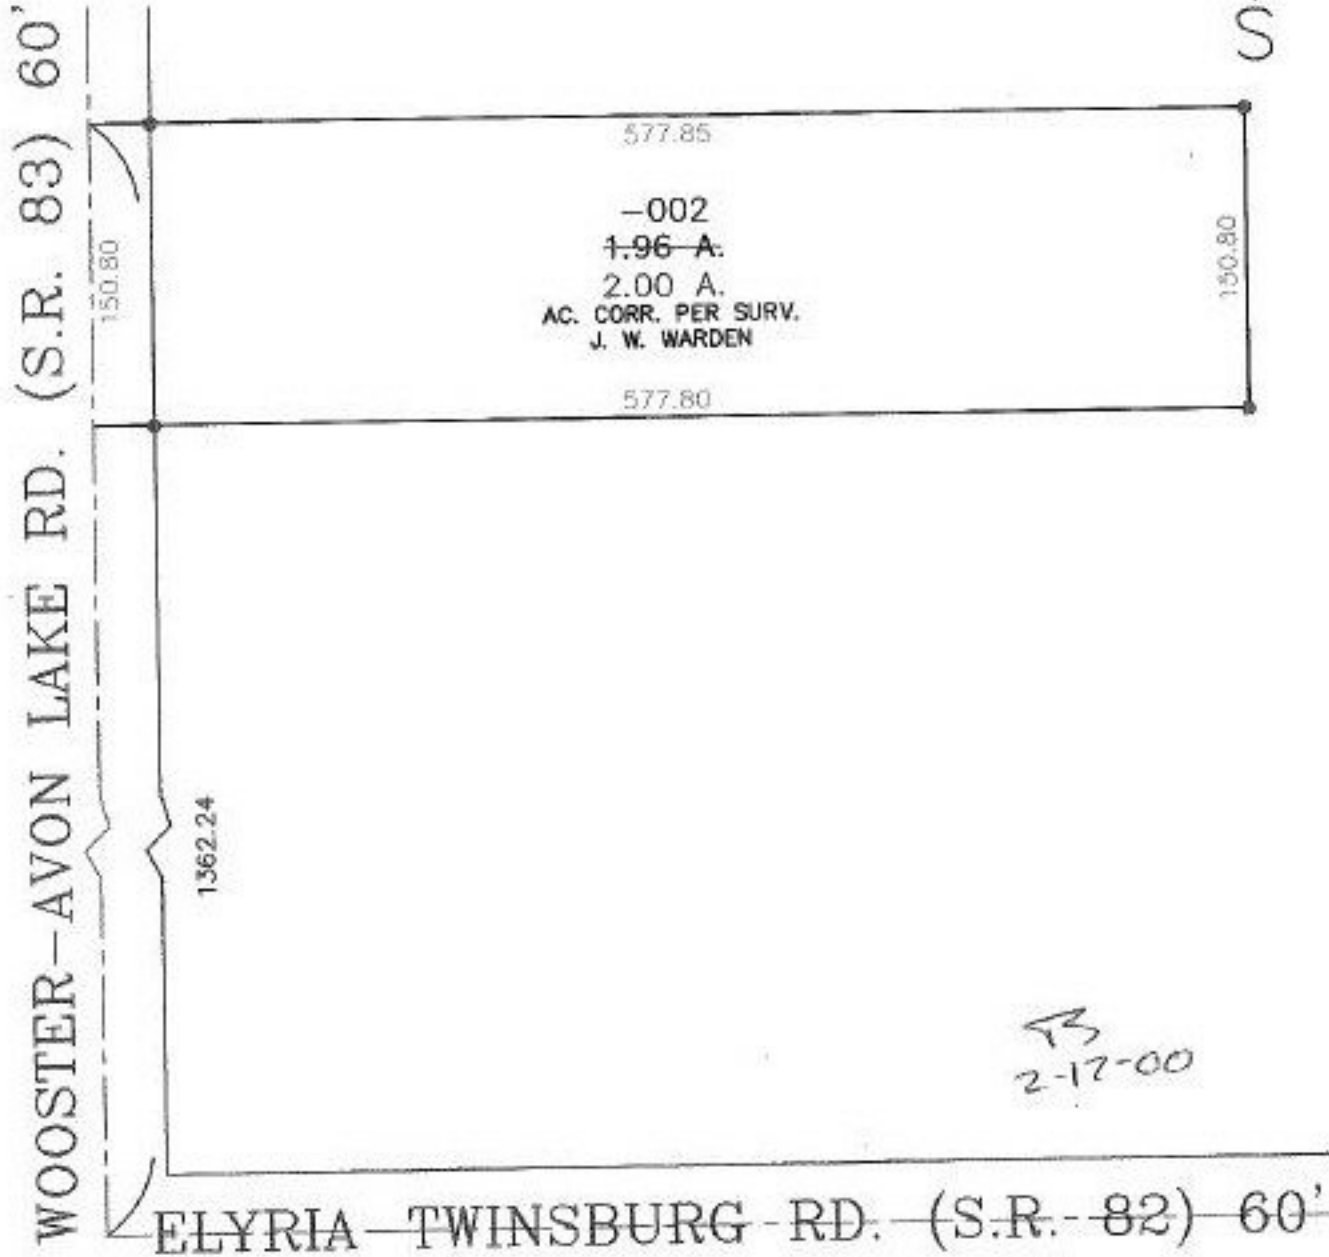

SPLITS/DEEDS PROCESSED
 LORAIN COUNTY TAX MAP DEPARTMENT
 226 MIDDLE AVE. ELYRIA, OHIO

SURVEYED BY: J.W. WARDEN
 CLOSURE: CAN'T RUN
 MAP PAGE(S): 11-00-046-A
 APPROVED BY: TJS DATE: 06/29/99
 SCALE: 1" = 100' PRIOR INSTRUMENT: OR 1327/B17