

PARENT PARCEL: 05-00-024-113-021

CHILD PARCEL: XXXXXXXXXXXX

STARTING POINT: N.W. CORNER OF S\ 202 IN HARRIS HEIR ADDITION

NO. 00094-D

# DEED CHECK


05-00-024-113-021

~~51.50 X 137.50~~

51.50 X 143.80

FRONTAGE & DEPTH CORR. PER DEED

#970471517

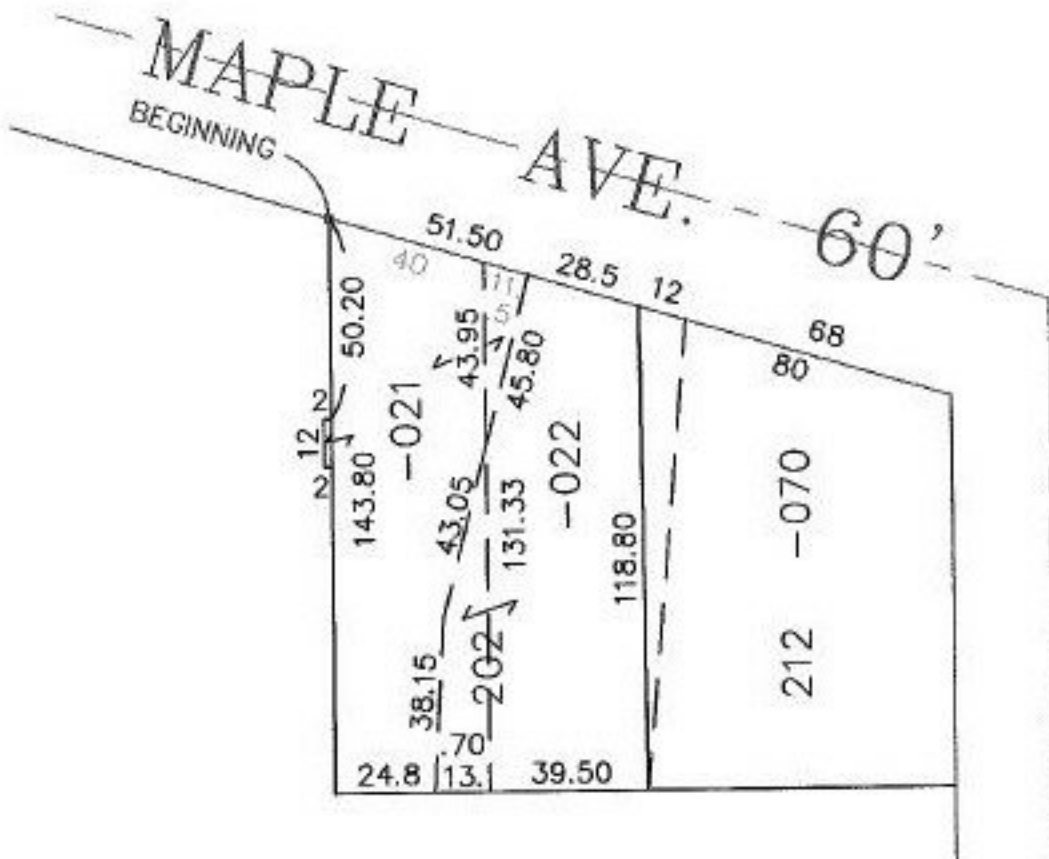

TS  
3-31-00

## SPLITS/DEEDS PROCESSED

LORAIN COUNTY TAX MAP DEPARTMENT  
226 MIDDLE AVE. ELYRIA, OHIO

SURVEYED BY: NONE

CLOSURE: CAN'T RUN

MAP PAGE(S): 05-00-024-B

APPROVED BY: TJS DATE: 07/02/99

SCALE: 1" = 50' PRIOR INSTRUMENT: DV 1236/490