


PARENT PARCEL: 04-00-012-103-135

CHILD PARCEL: XXXXXXXXXXXX

STARTING POINT: CL OF STANEY RIDGE RD. & S.W. CORNER OF LAND CONVEYED

TO LAWRENCE LEONARD JR.

NO. 00097-D

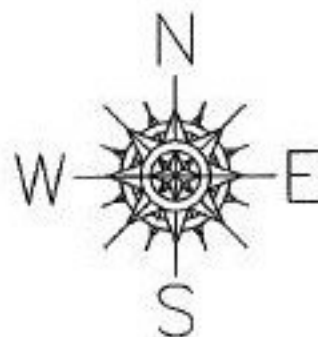

DEED CHECK

04-00-012-103-135

43.25 A.

SURVEY & UPDATE LEGAL
BEFORE NEXT TRANSFER

CAN'T DRAW MAP

TS
3-31-00



SPLITS/DEEDS PROCESSED

LORAIN COUNTY TAX MAP DEPARTMENT
226 MIDDLE AVE. ELYRIA, OHIO

SURVEYED BY: NONE

CLOSURE: CAN'T RUN

MAP PAGE(S): 04-00-012-C

APPROVED BY: I. SPILLMAN DATE: 12/27/99

SCALE: 1" = 50' PRIOR INSTRUMENT: XXXXXXXXXXX