
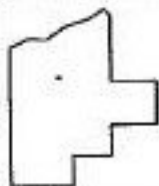


PARENT PARCEL: 07-00-026-101-055

CHILD PARCEL: 07-00-026-101-057, -058

STARTING POINT: CENTERLINE OF SUGAR RIDGE RD. & WOOSTER AVON LAKE RD.

NO. 00100

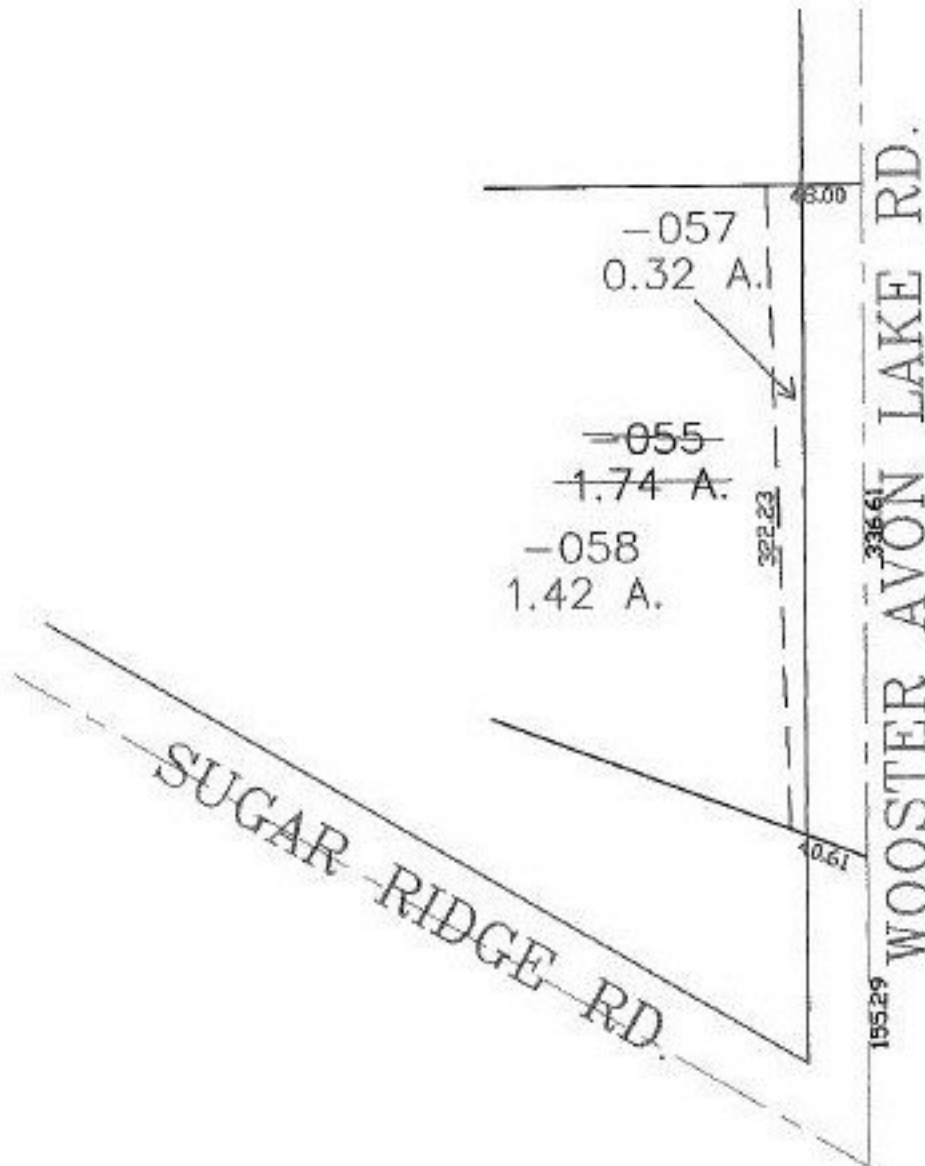

**SPLITS/DEEDS PROCESSED**  
 LORAIN COUNTY TAX MAP DEPARTMENT  
 226 MIDDLE AVE. ELYRIA, OHIO

SURVEYED BY: ROBERT A. MCAULEY  
 CLOSURE: 0.00 : 10.000  
 MAP PAGE(S): 07-00-026-B  
 APPROVED BY: JAH DATE: 4-28-04  
 SCALE: 1" = 100' PRIOR INSTRUMENT: 19980558086