


CARLISLE TWP.

SECS 17, 18

SCALE: 1" = 400'

Copyright 1963
Rev. 9-30-75

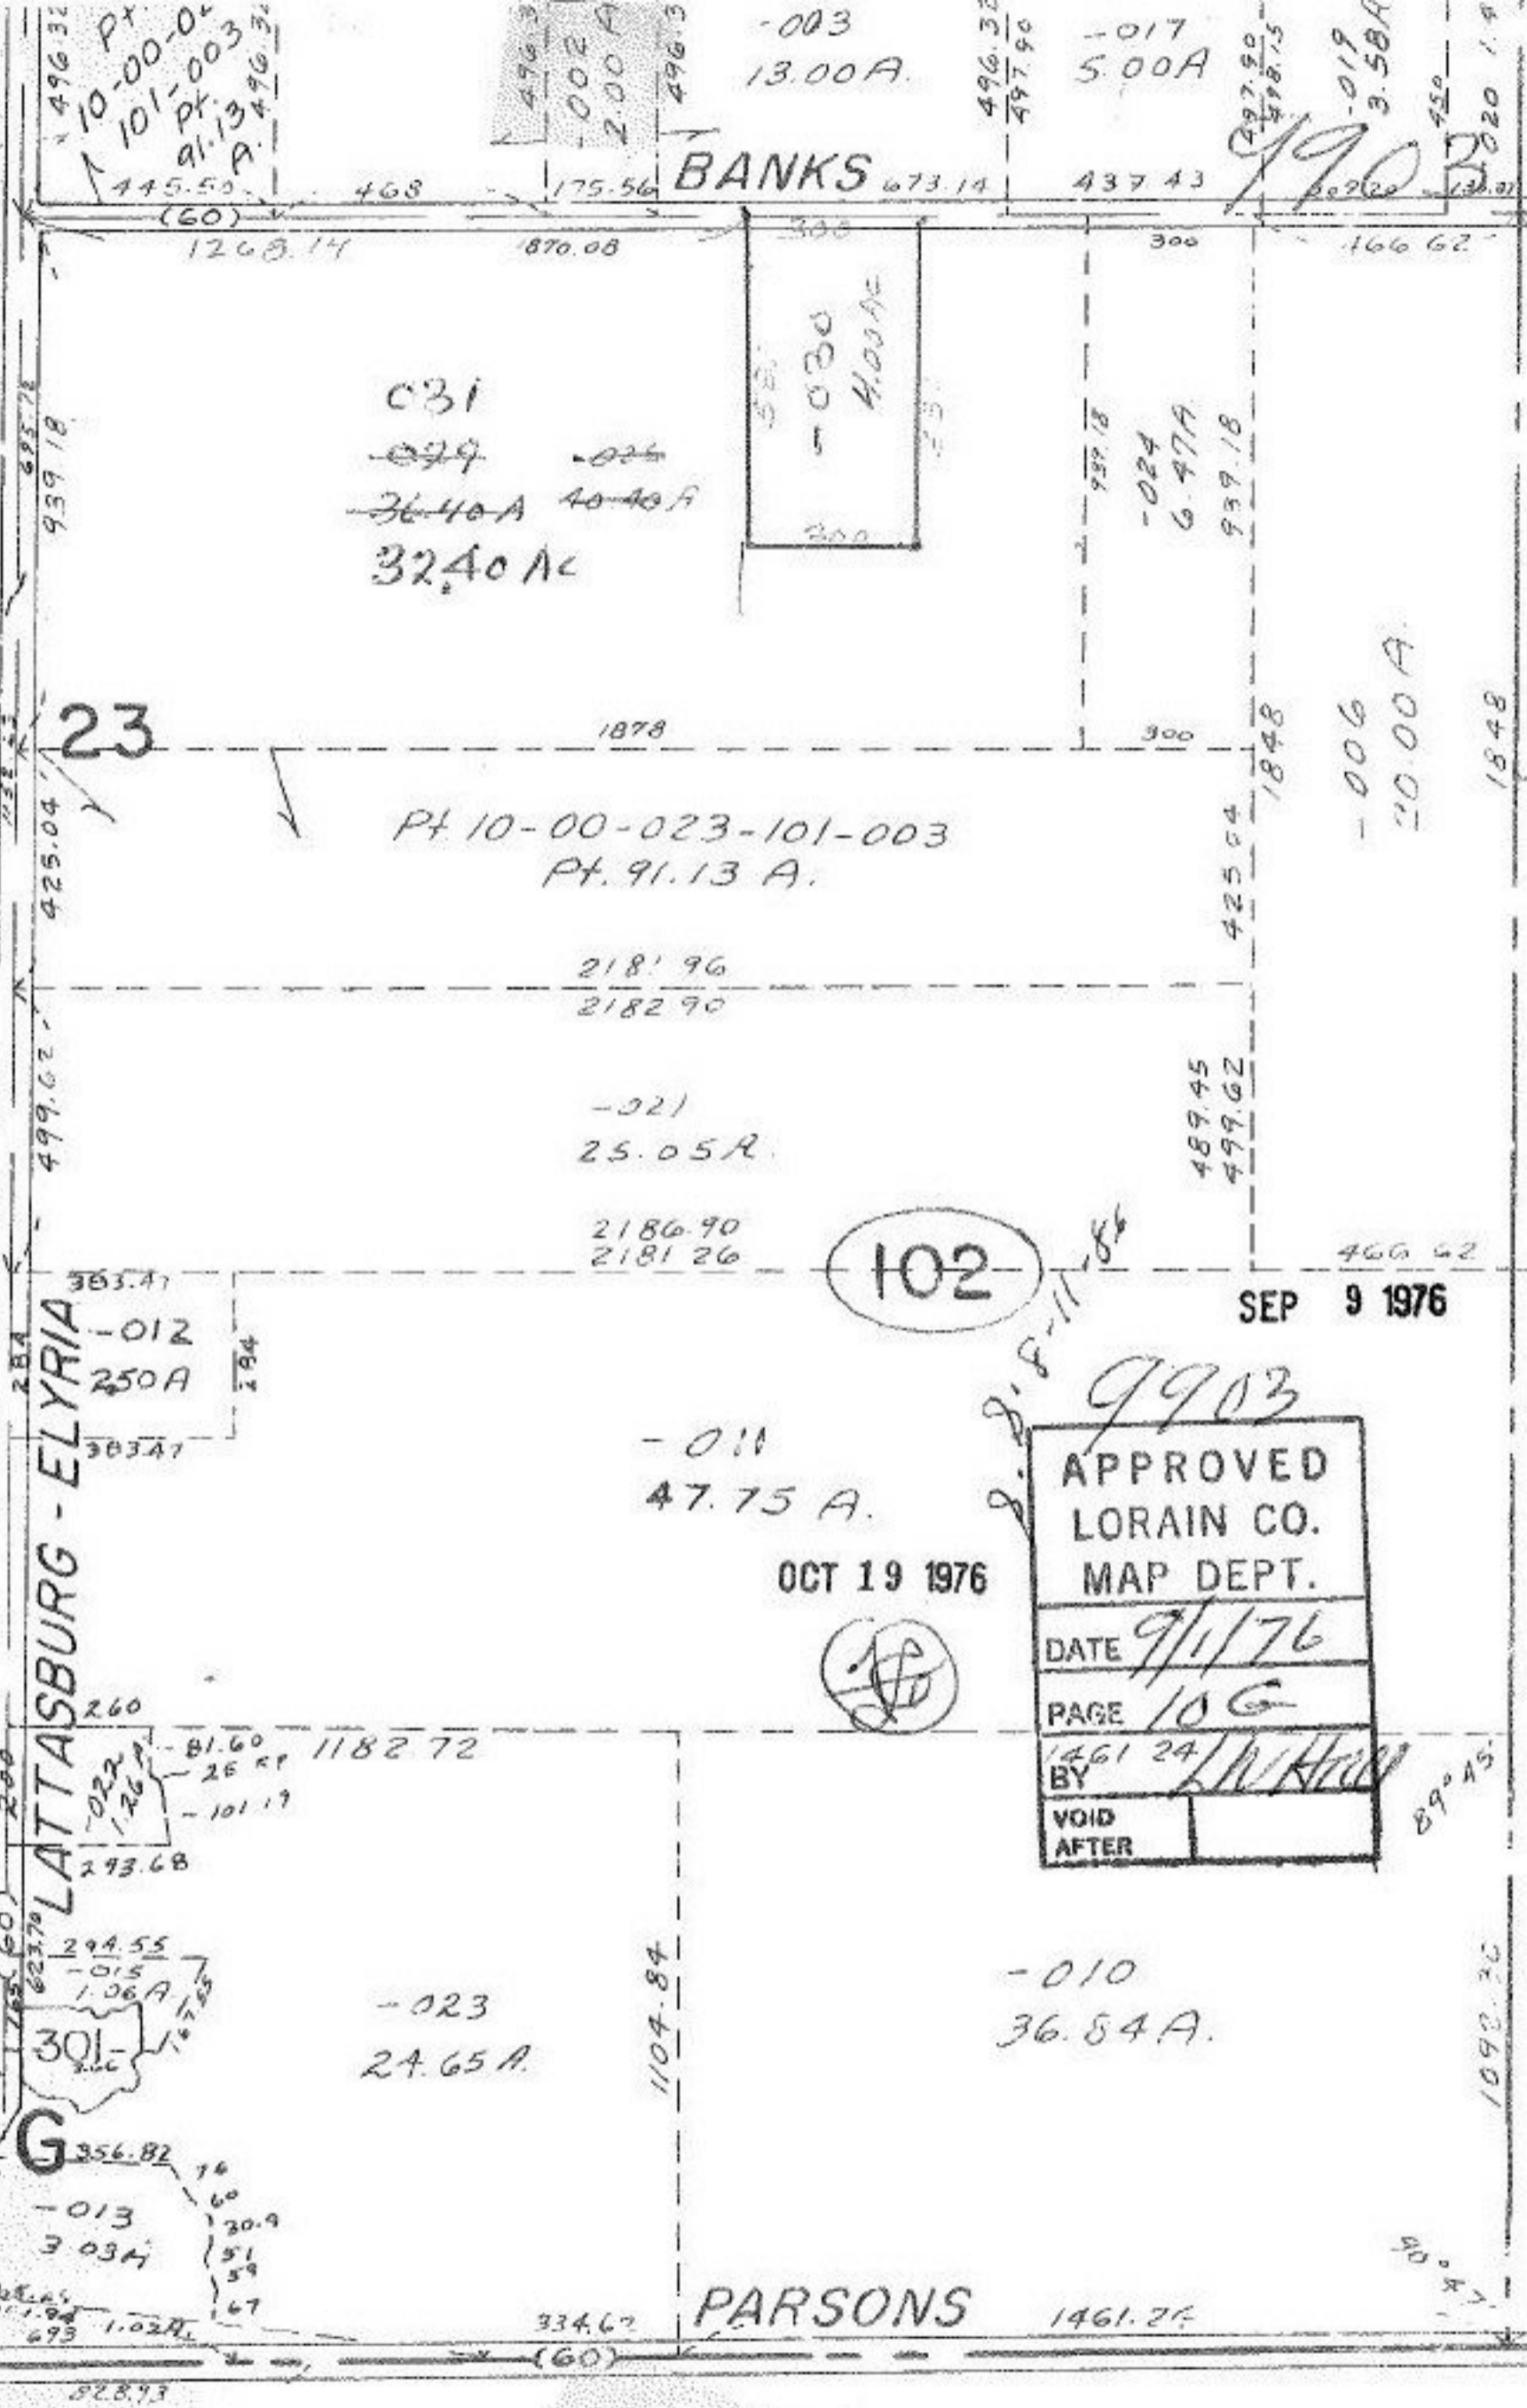

9903

APPROVED
LORAIN CO.
MAP DEPT.

DATE 9/1/76

PAGE 106

BY [Signature]

VOID AFTER


OCT 19 1976

SEP 9 1976

102

89° 45'

1092.70

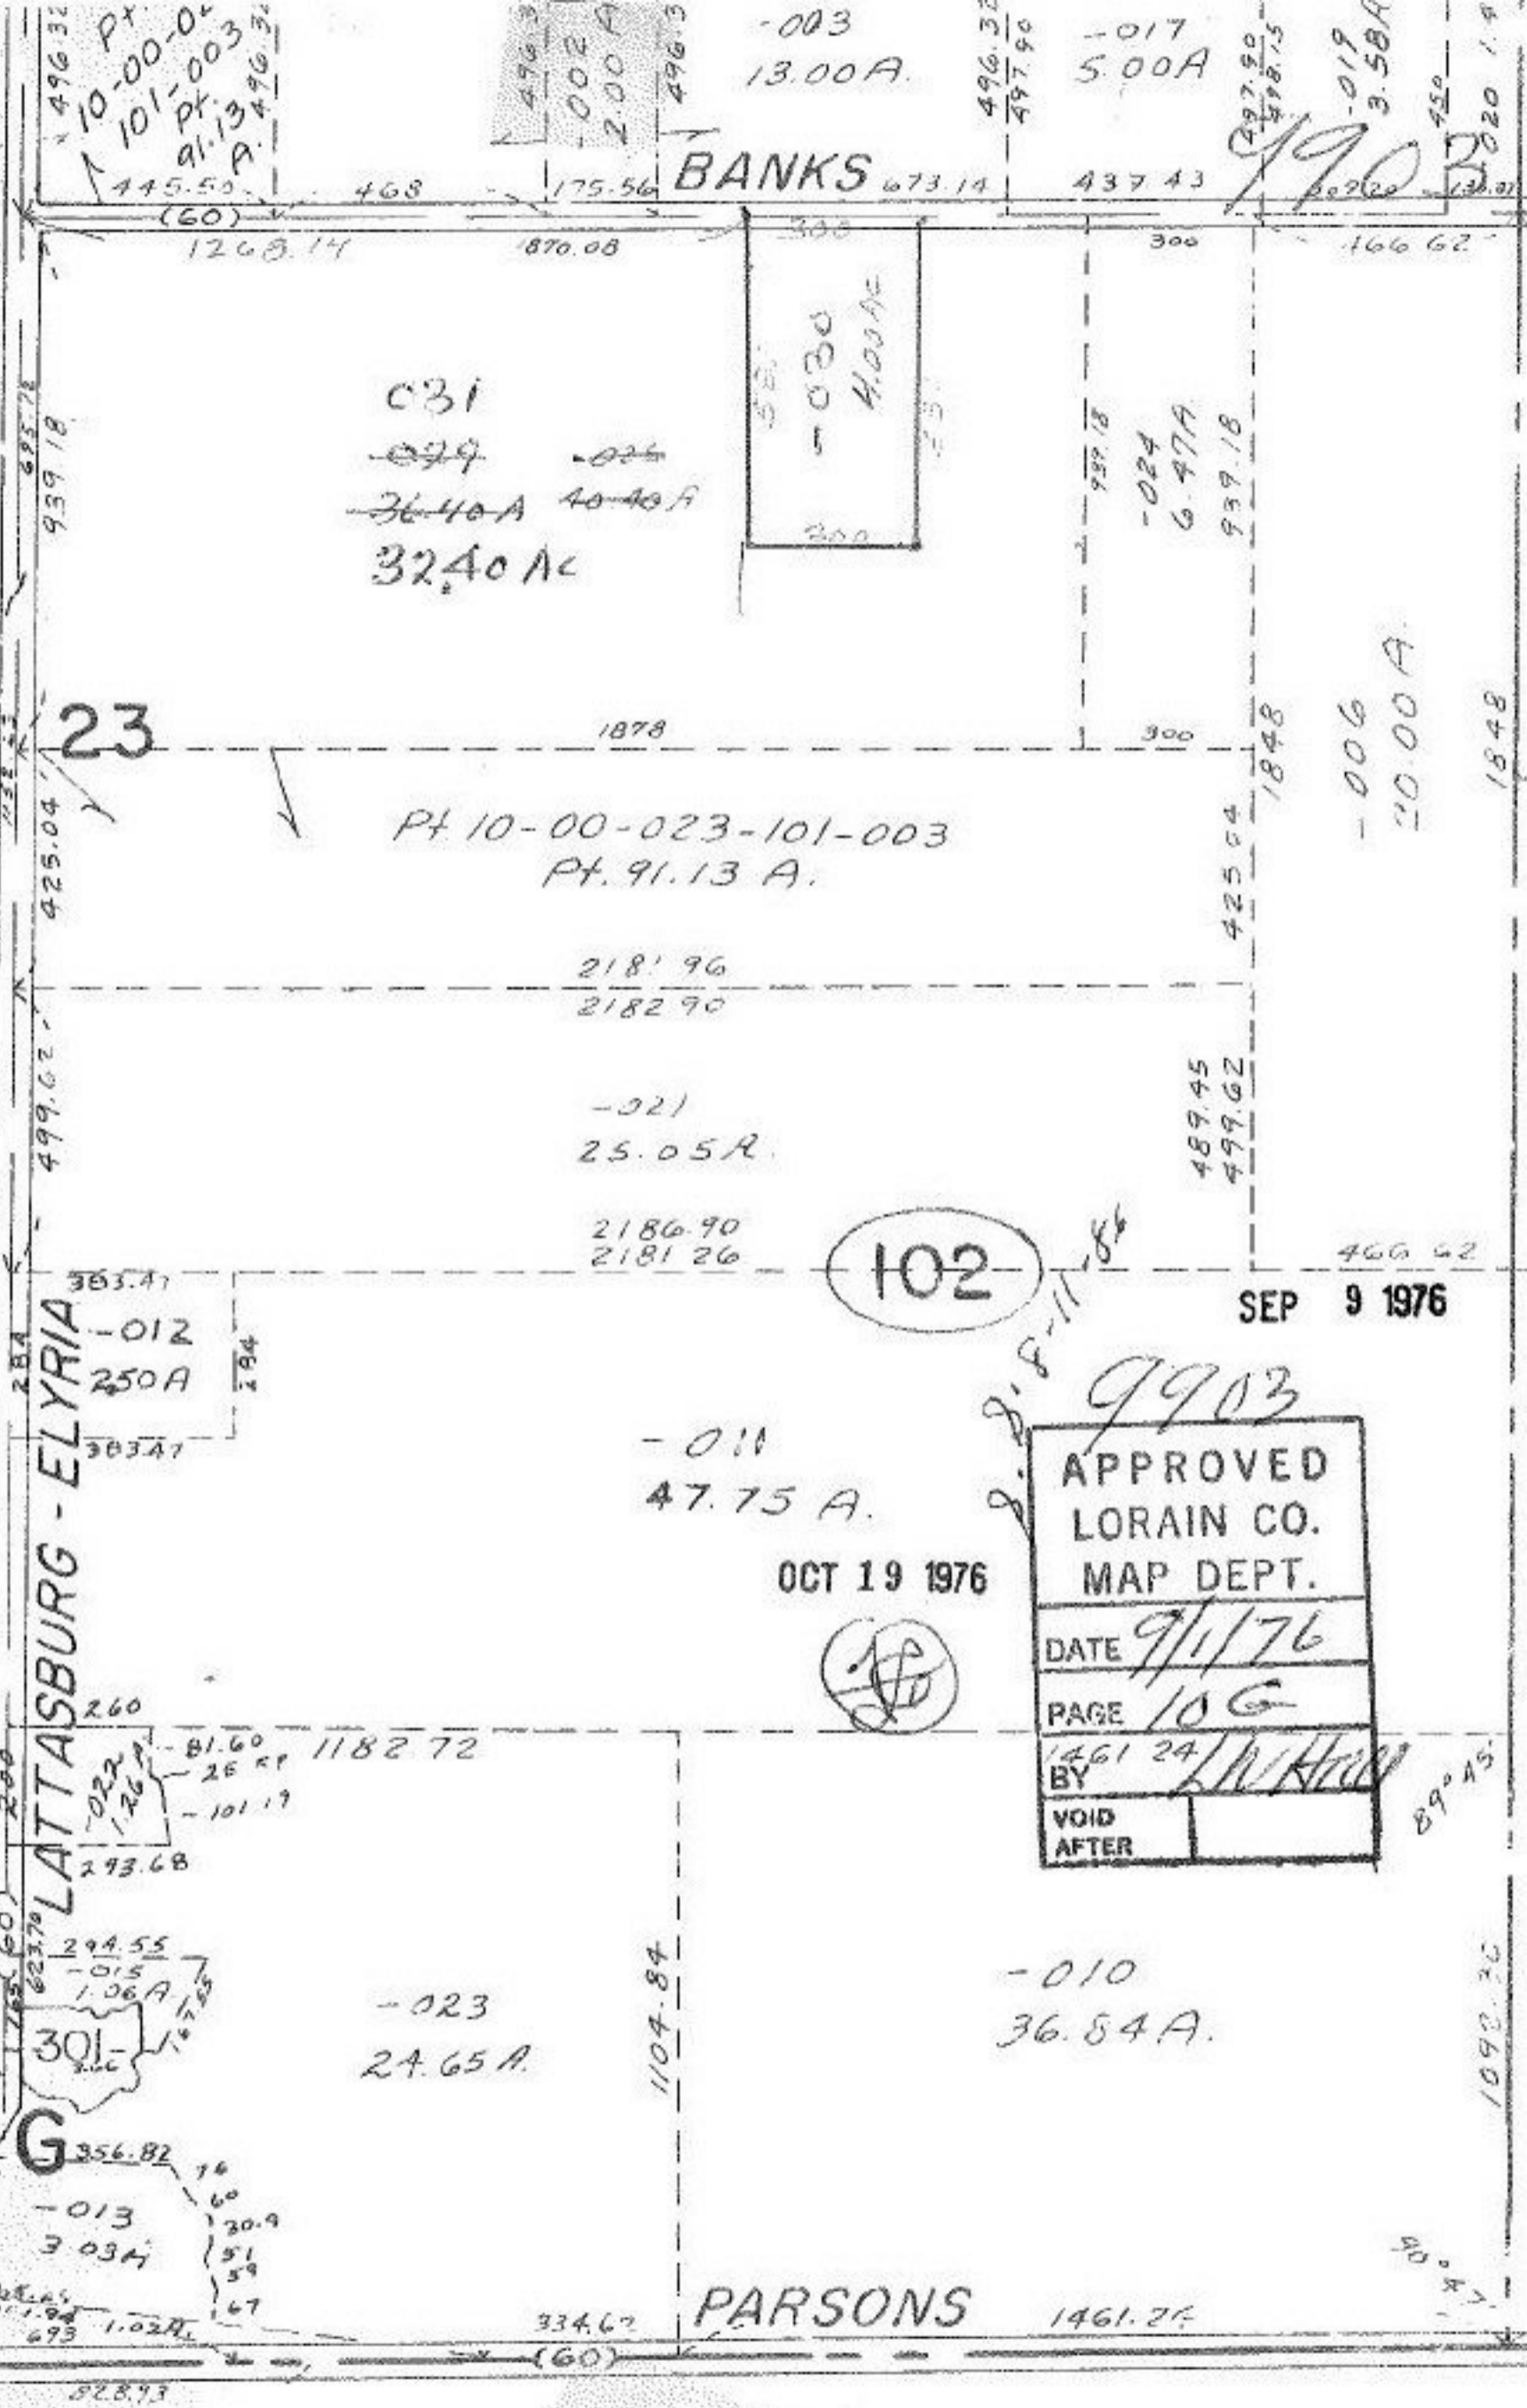

9903

APPROVED
LORAIN CO.
MAP DEPT.

DATE 9/1/76

PAGE 106

BY [Signature]

VOID AFTER

OCT 19 1976

SEP 9 1976

102

89° 45'

1092.70