

9911

-003  
47.65 A.

26

-004

31.00 A.


-001  
49.00 A.

18

SEP 3 1976

25

~~002~~  
76.99 A.  
~~005~~  
70.34 A.

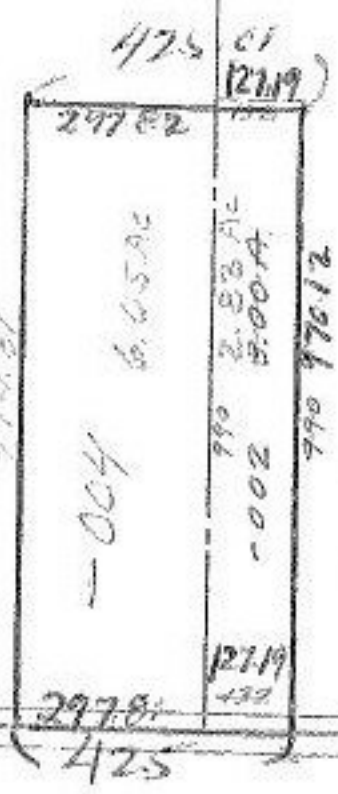

MAR 11 1977

*[Signature]*

42.90 A.

APPROVED	
LORAIN	
MAP DEPT	
DATE	9/3/76
PAGE	21A
BY	L. N. Hall
VOID AFTER	

11965 -006  
4.10 A.

17

936