


9914  
10-249

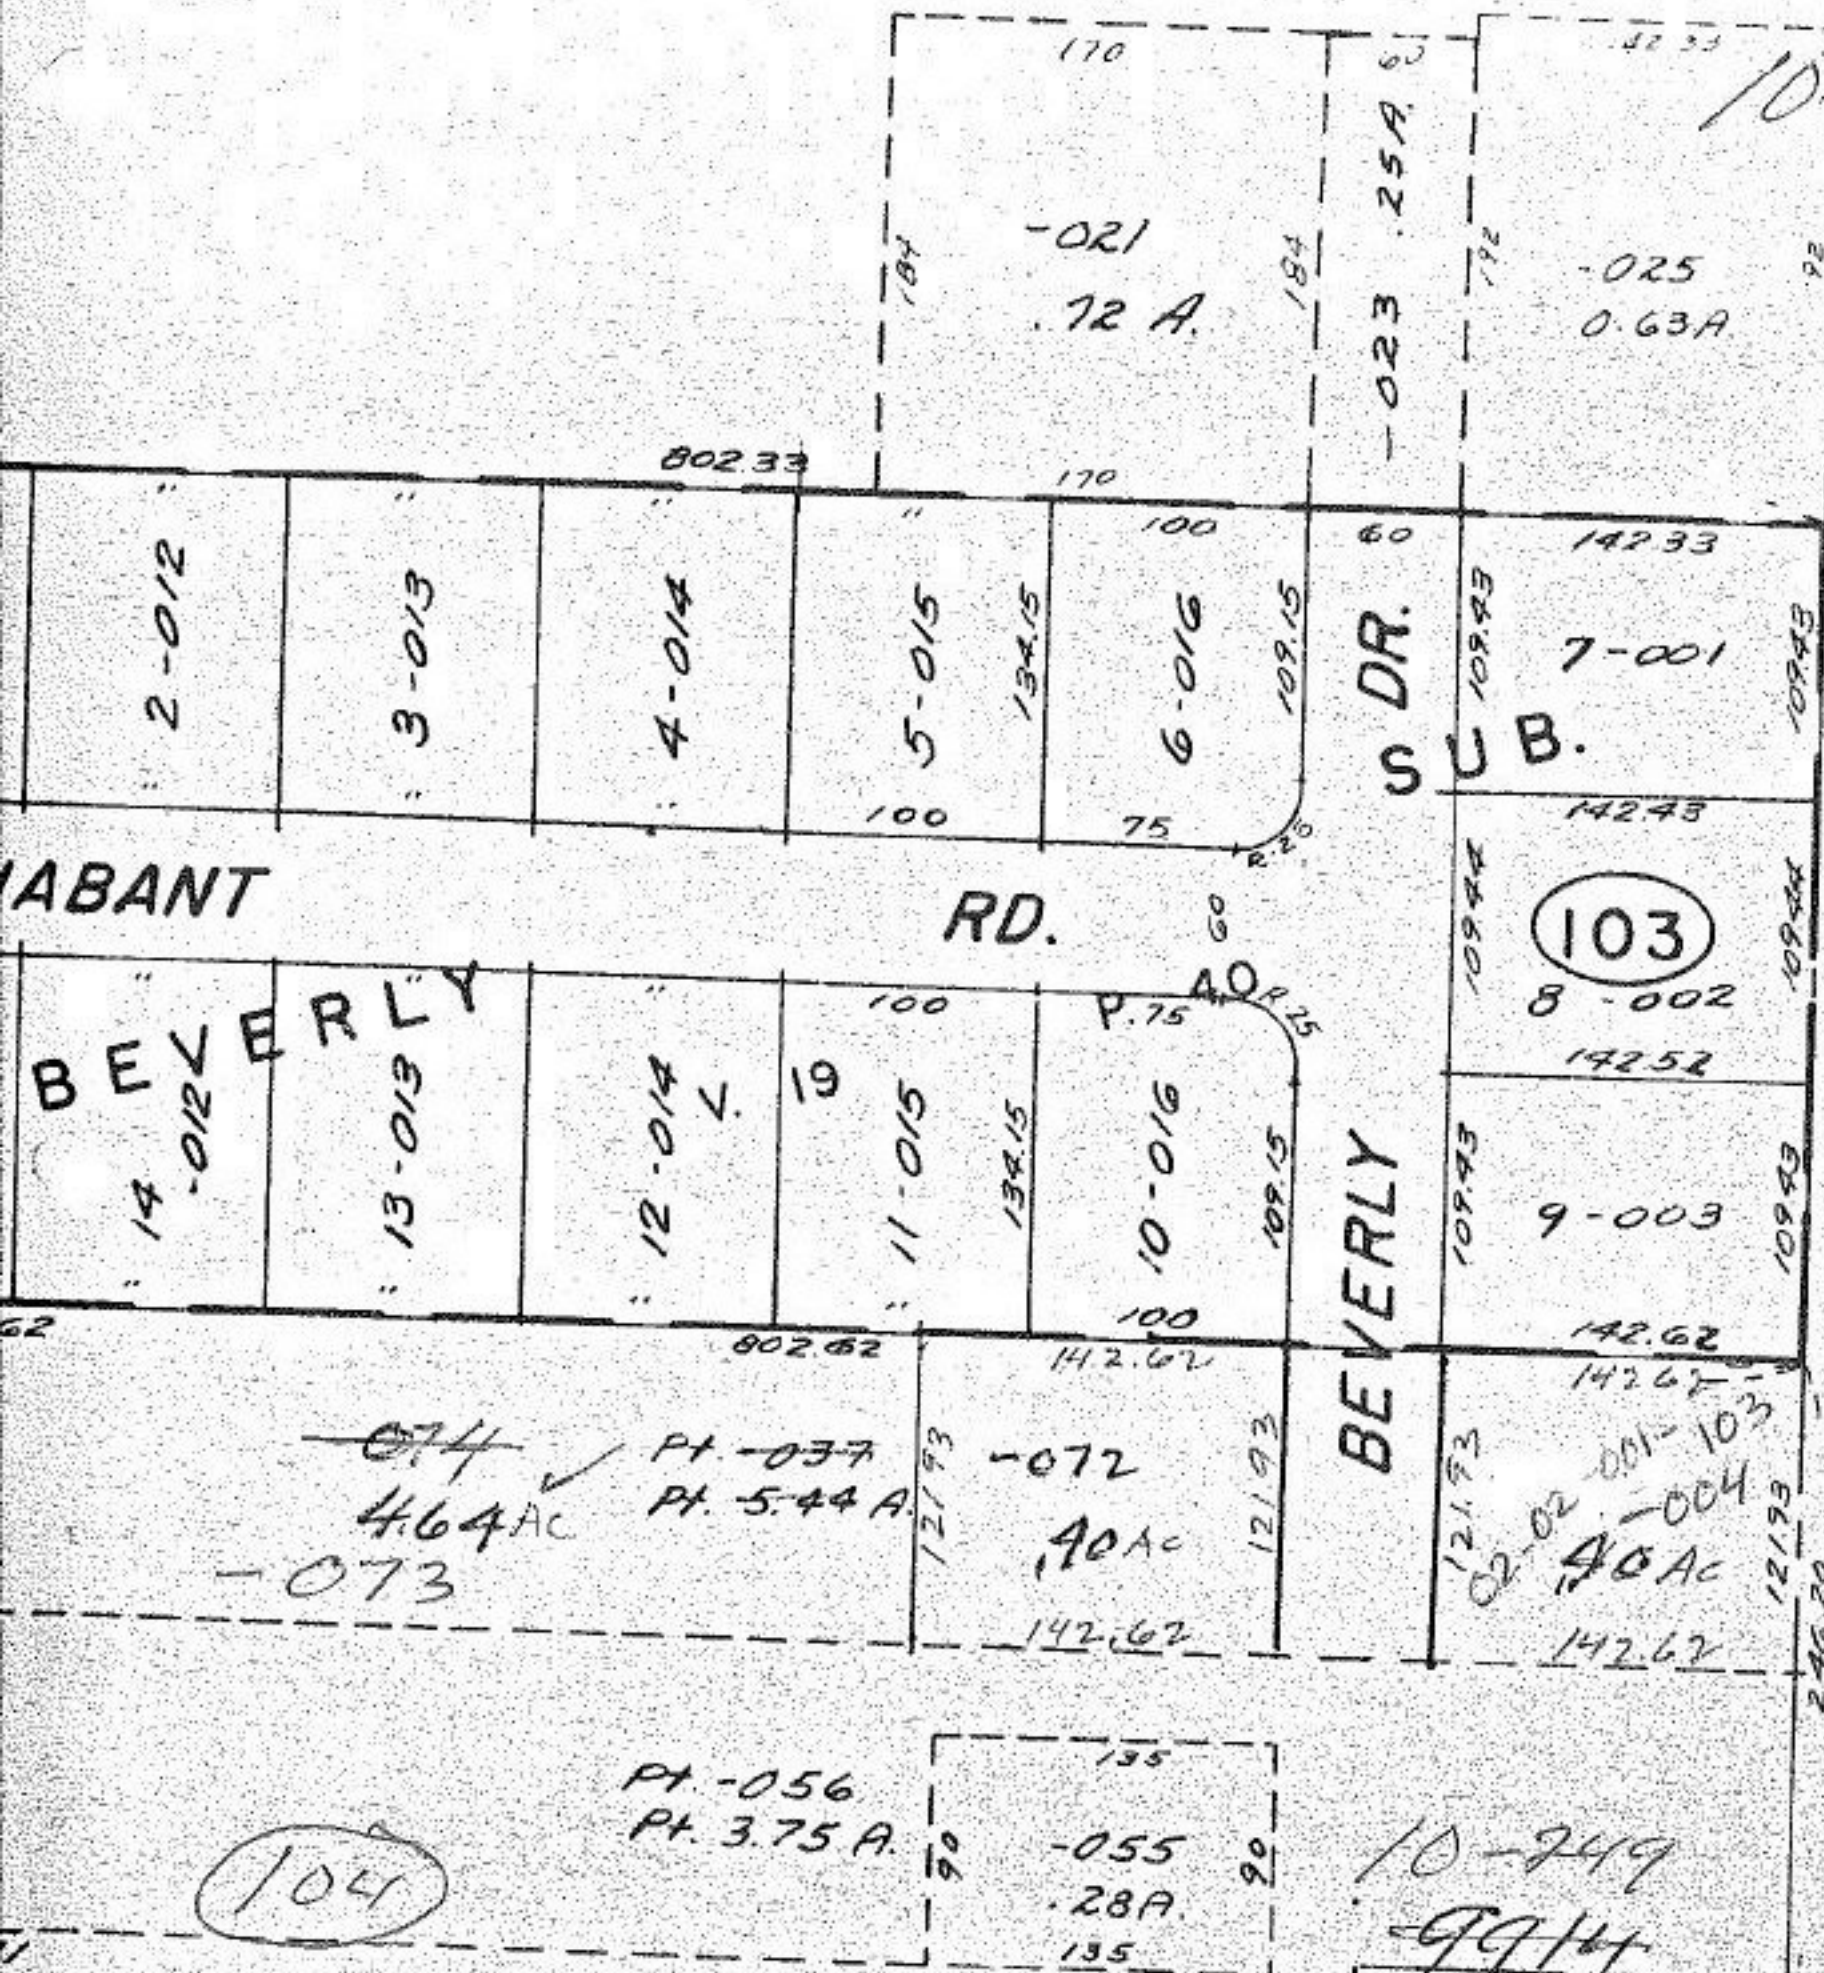

SEP 9 1976

SEE 2-F

JAN 7 1977

MAY 6 1977

*[Handwritten signature]*  
B. B. 8-11-76

APPROVED  
LORAIN CO.  
MAP DEPT.

DATE 9/3/76

PAGE 2-02-001B

104