
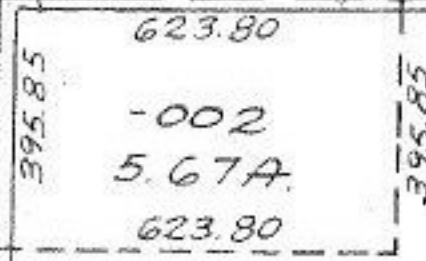


9924


62

-002
70.00 A.


Chamberlain Rd

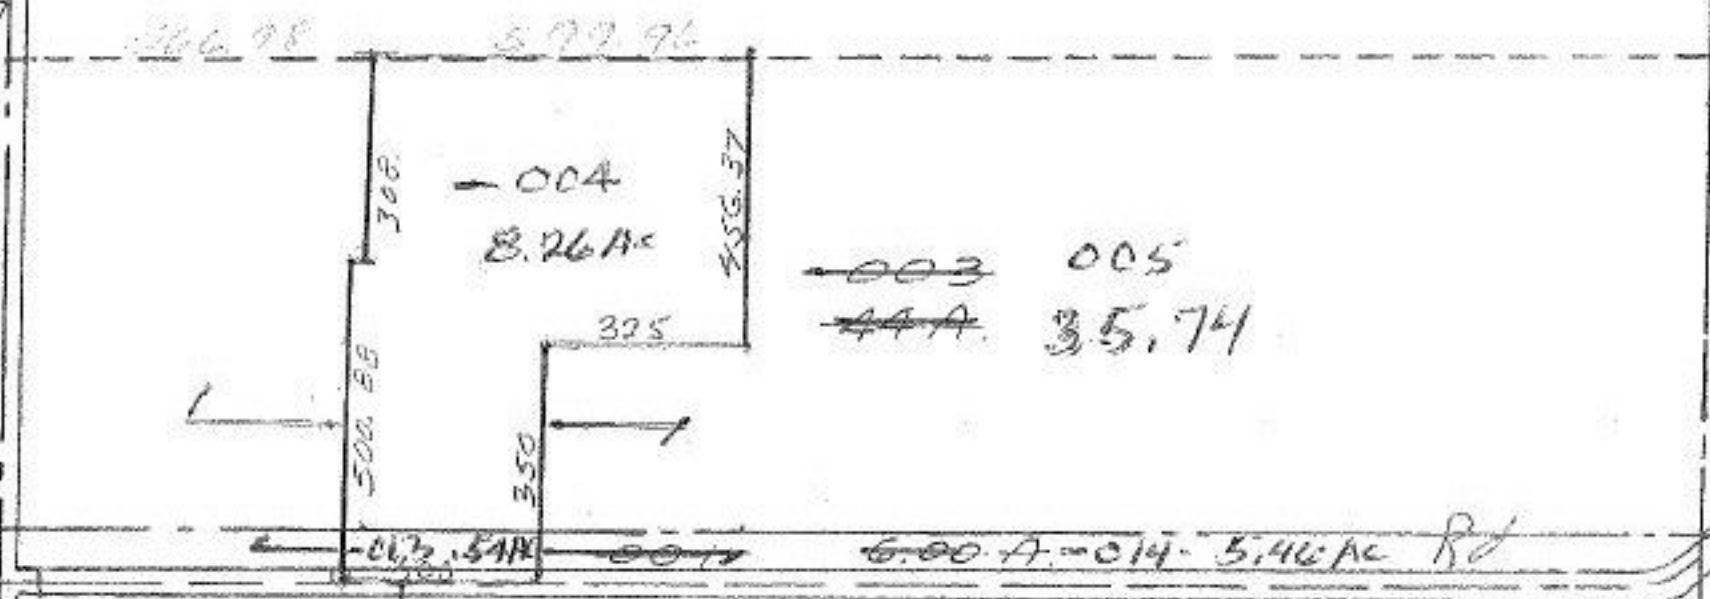

-003
49.33 A.

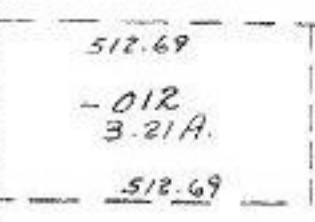

SEP 10 1976

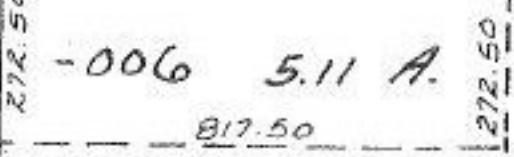

79 -007
2658.11

FEB 25 1977

APPROVED
LORAIN CO.
MAP DEPT.

DATE 9/10/76

PAGE 1 of 1

[Signature]

825

674

498.50

502.50

153

677.4

159.93

513.4

272.50

272.50

10.00 R

53.50

10 A.

653.72

54 A.

654

5. AC