

SEE 21-F FOR PARCEL NOS

OBERLIN

ASHLAND


TRACT NEW LONDON - EASTERN

9928

- 004
38.40 A.

- 001
57.37 A.

16

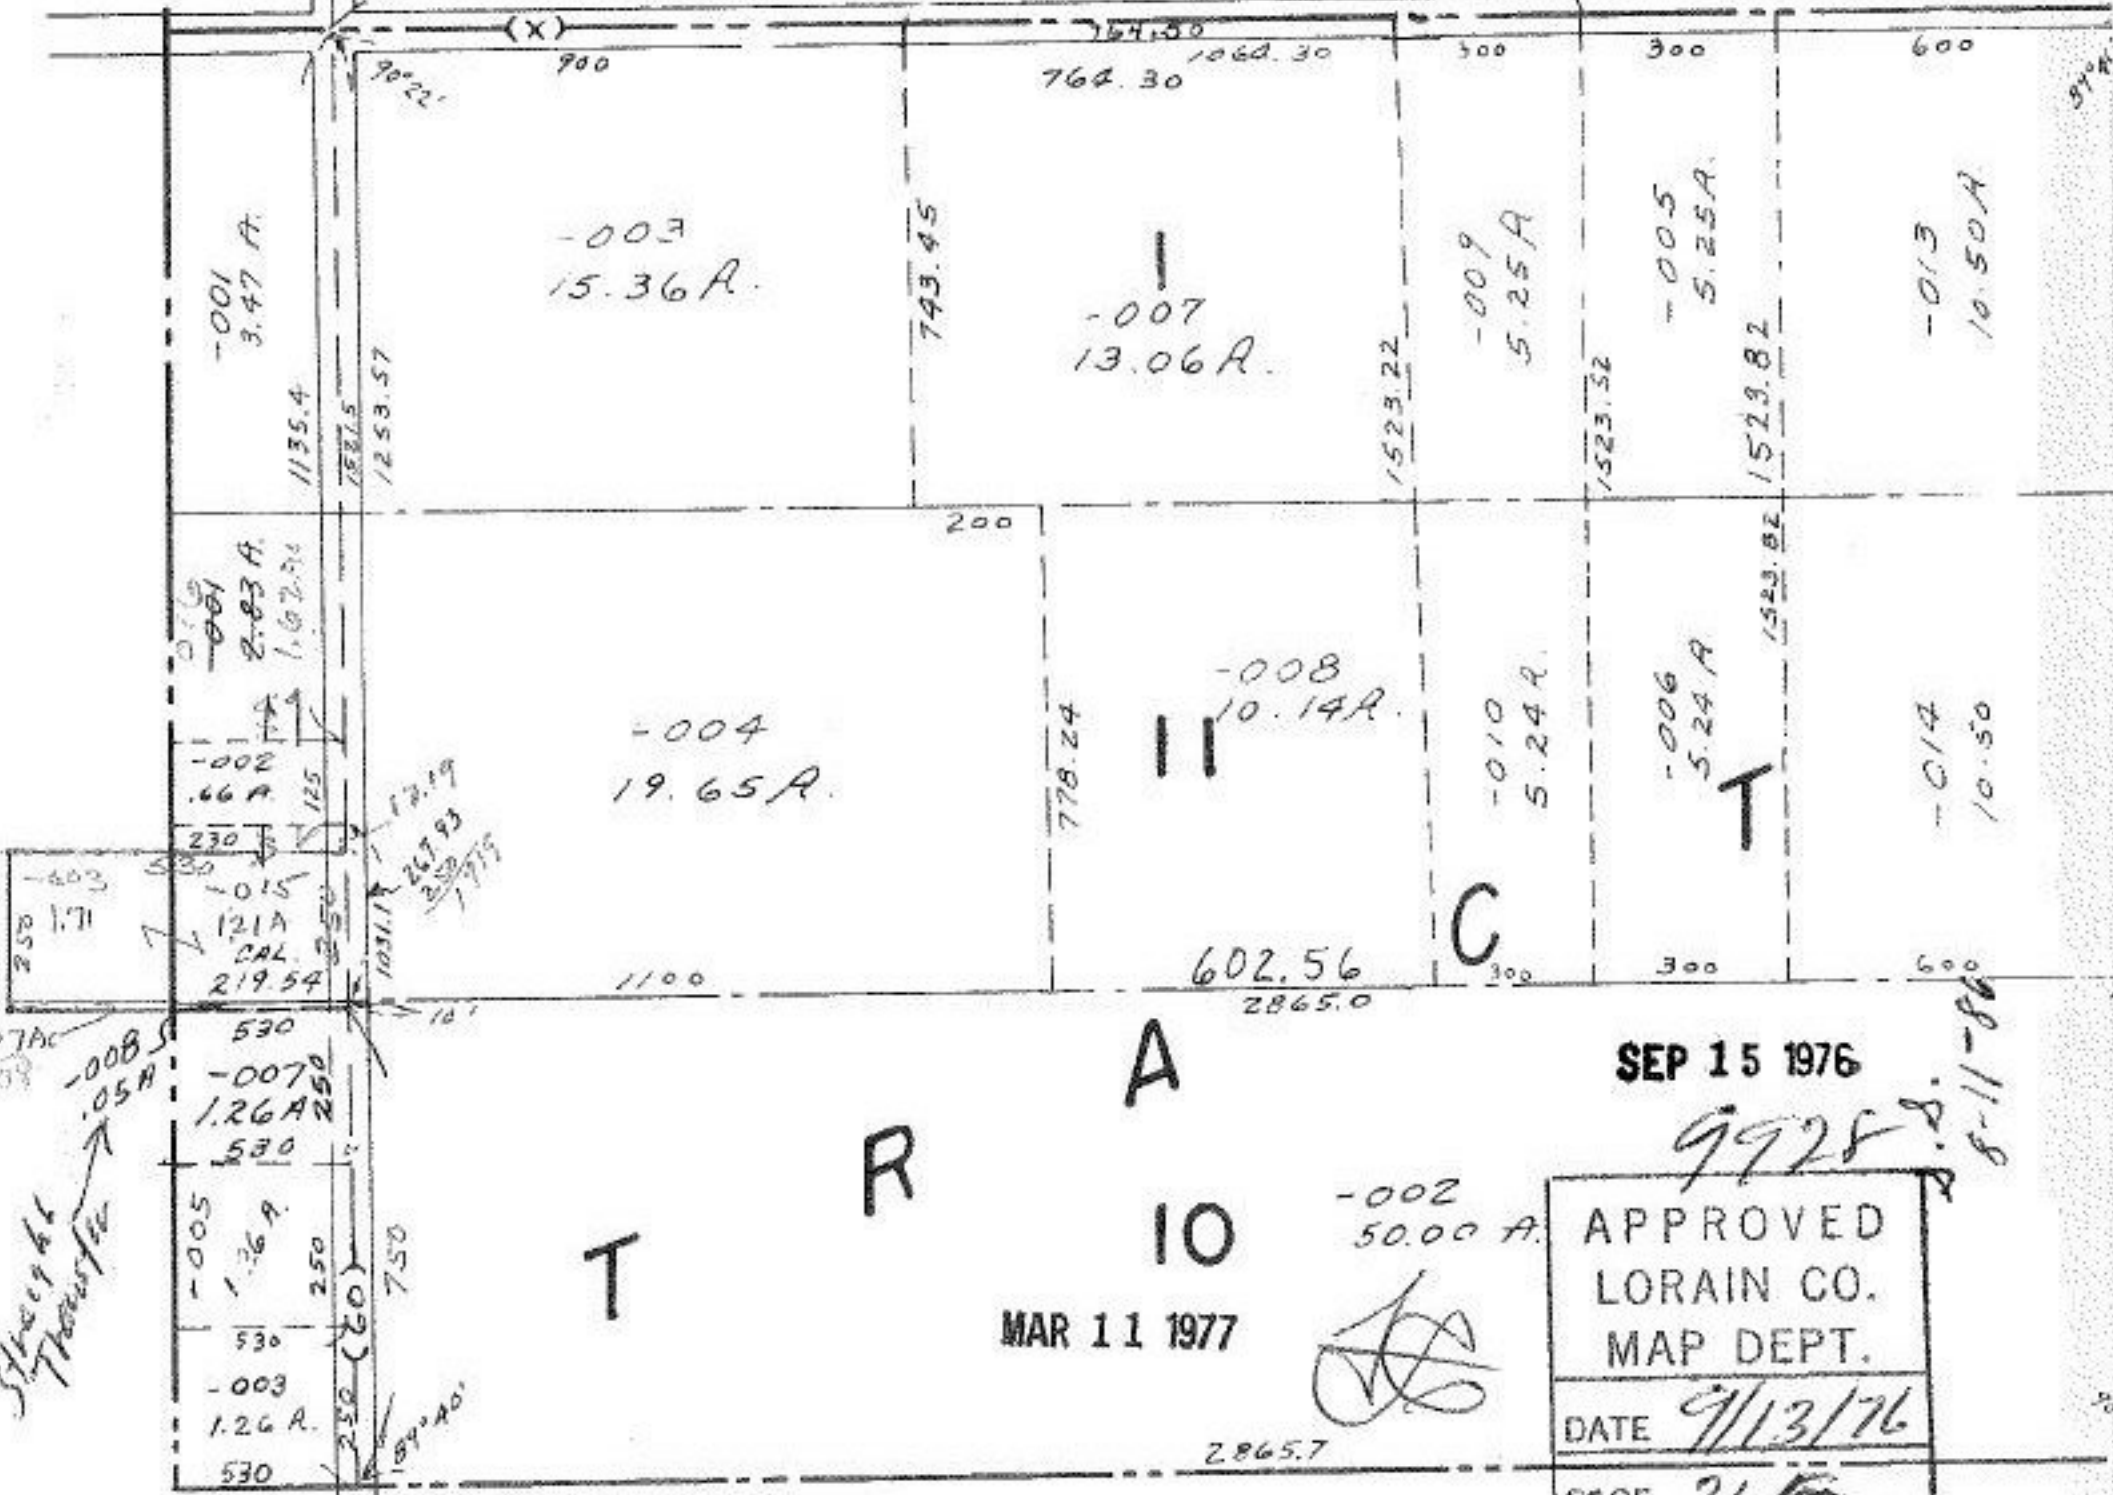

SEP 15 1976

9928

APPROVED
LORAIN CO.
MAP DEPT.

DATE 9/13/76

PAGE 21 E

BY L.W. Hall

VOID AFTER

MAR 11 1977

TRACT IO

HUNTINGTON TWP

Street Through

58

8-11-86