


SEE 6-81

BATH

46.25  
20  
26.25  
26.25  
66  
92.25  
10  
82.25

AUG 19 1977

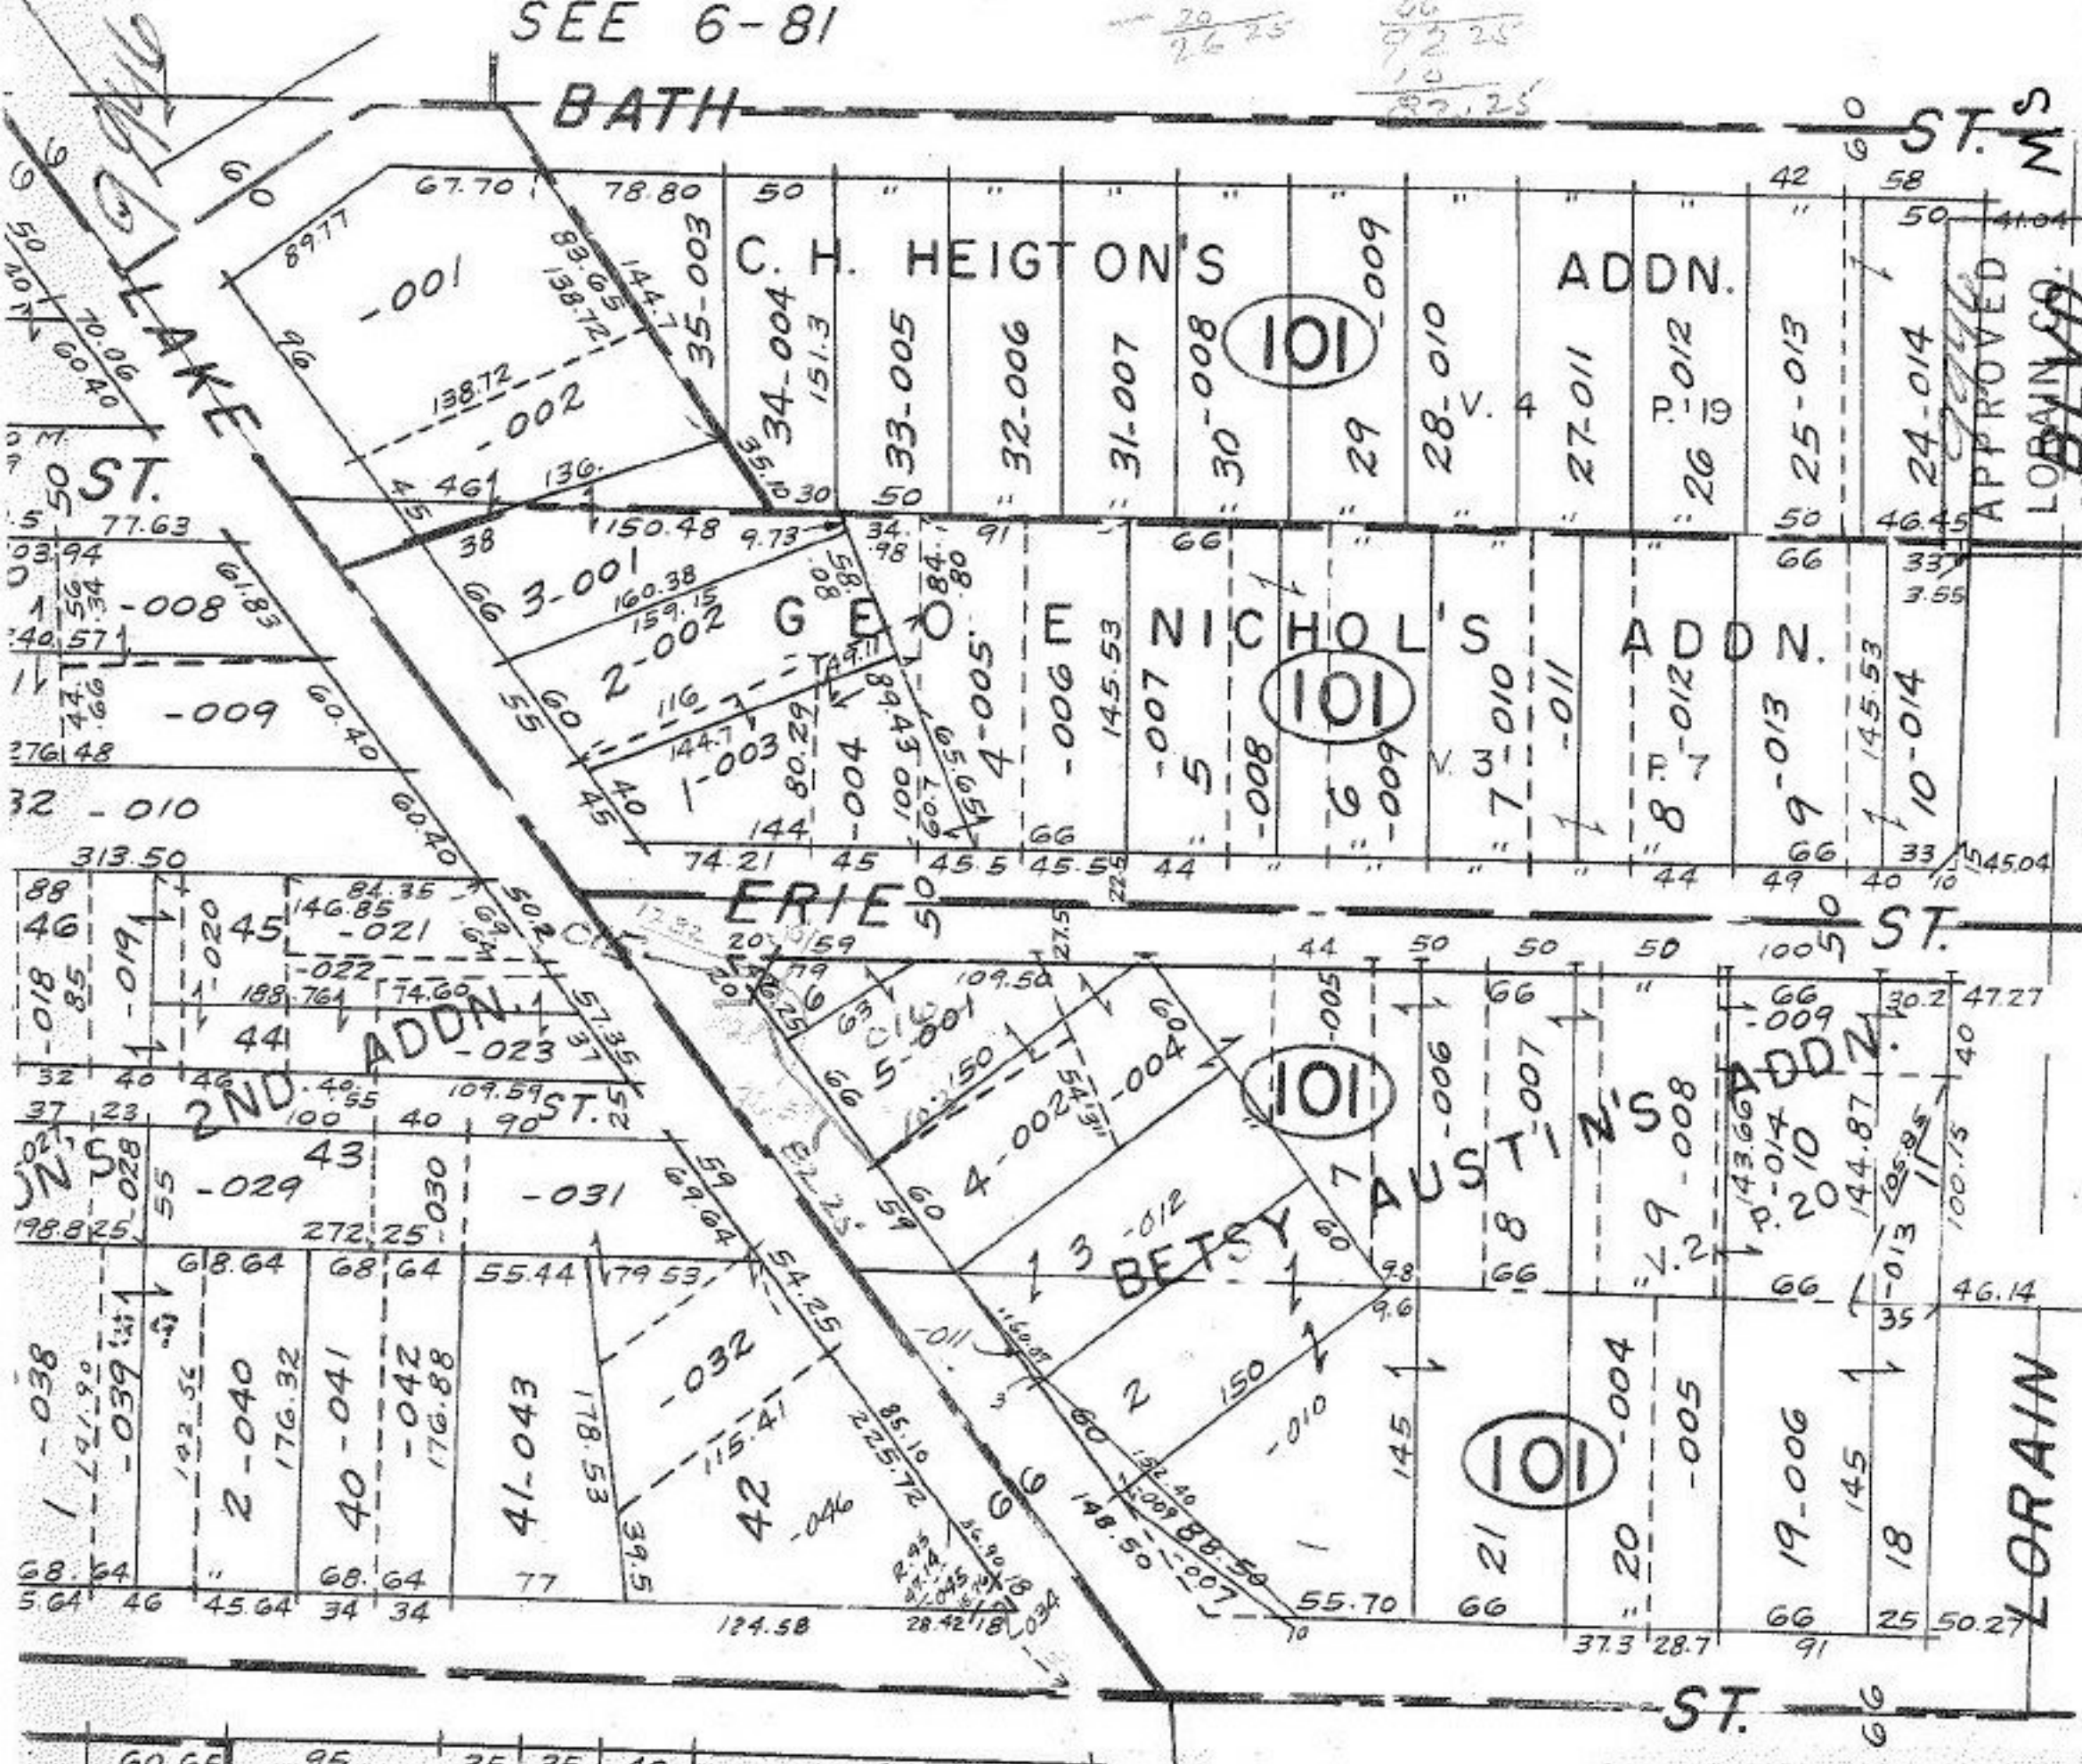

APPROVED  
LORAIN CO.  
MAP DEPT.

DATE 9/20/76  
PAGE 60  
BY [Signature]

NOV 5 1976

62

61

60

ST.