

9957

Butsley


RD.

(X)

100A
217.5

2038.36

Map Rd

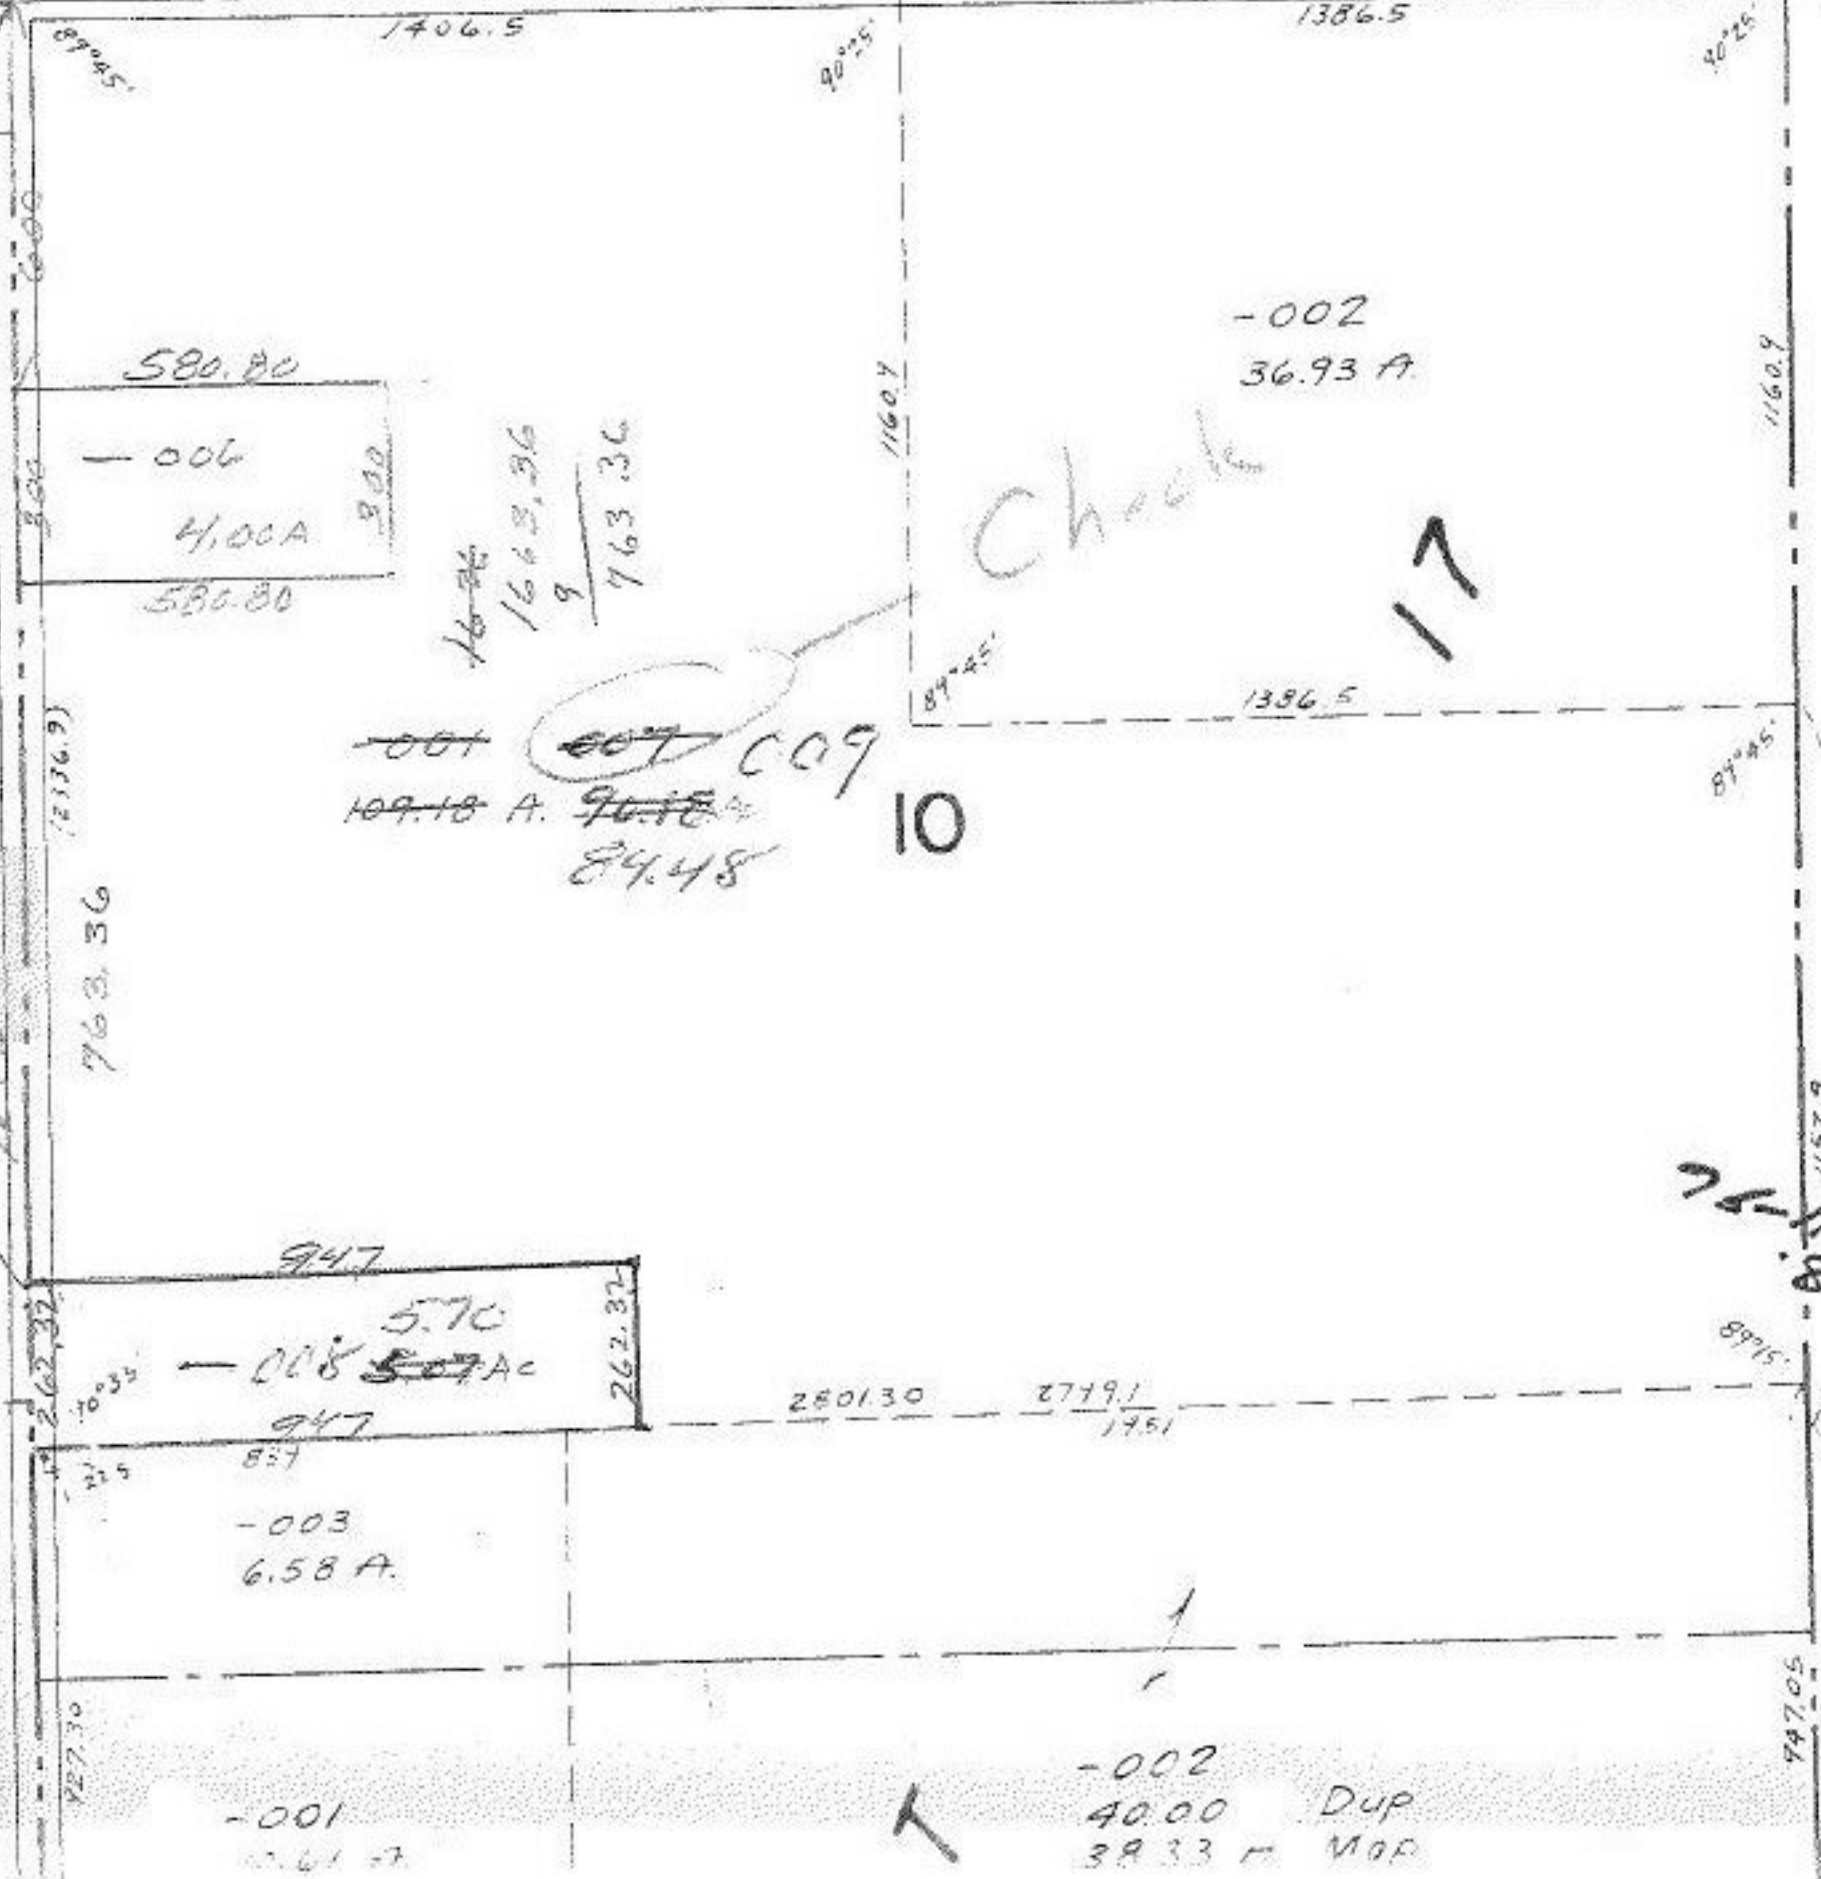

90.18
 570
 84.48

MAR 11 1977

SEP 24 1976

9957
 APPROVED
 LORAIN CO.
 MAP DEPT.

DATE 9/23/76

PAGE 21D

BY LW HAD

VOID AFTER 2:210 P.M.

-002
 40.00 Dup
 38.33 M. MOD