


9978

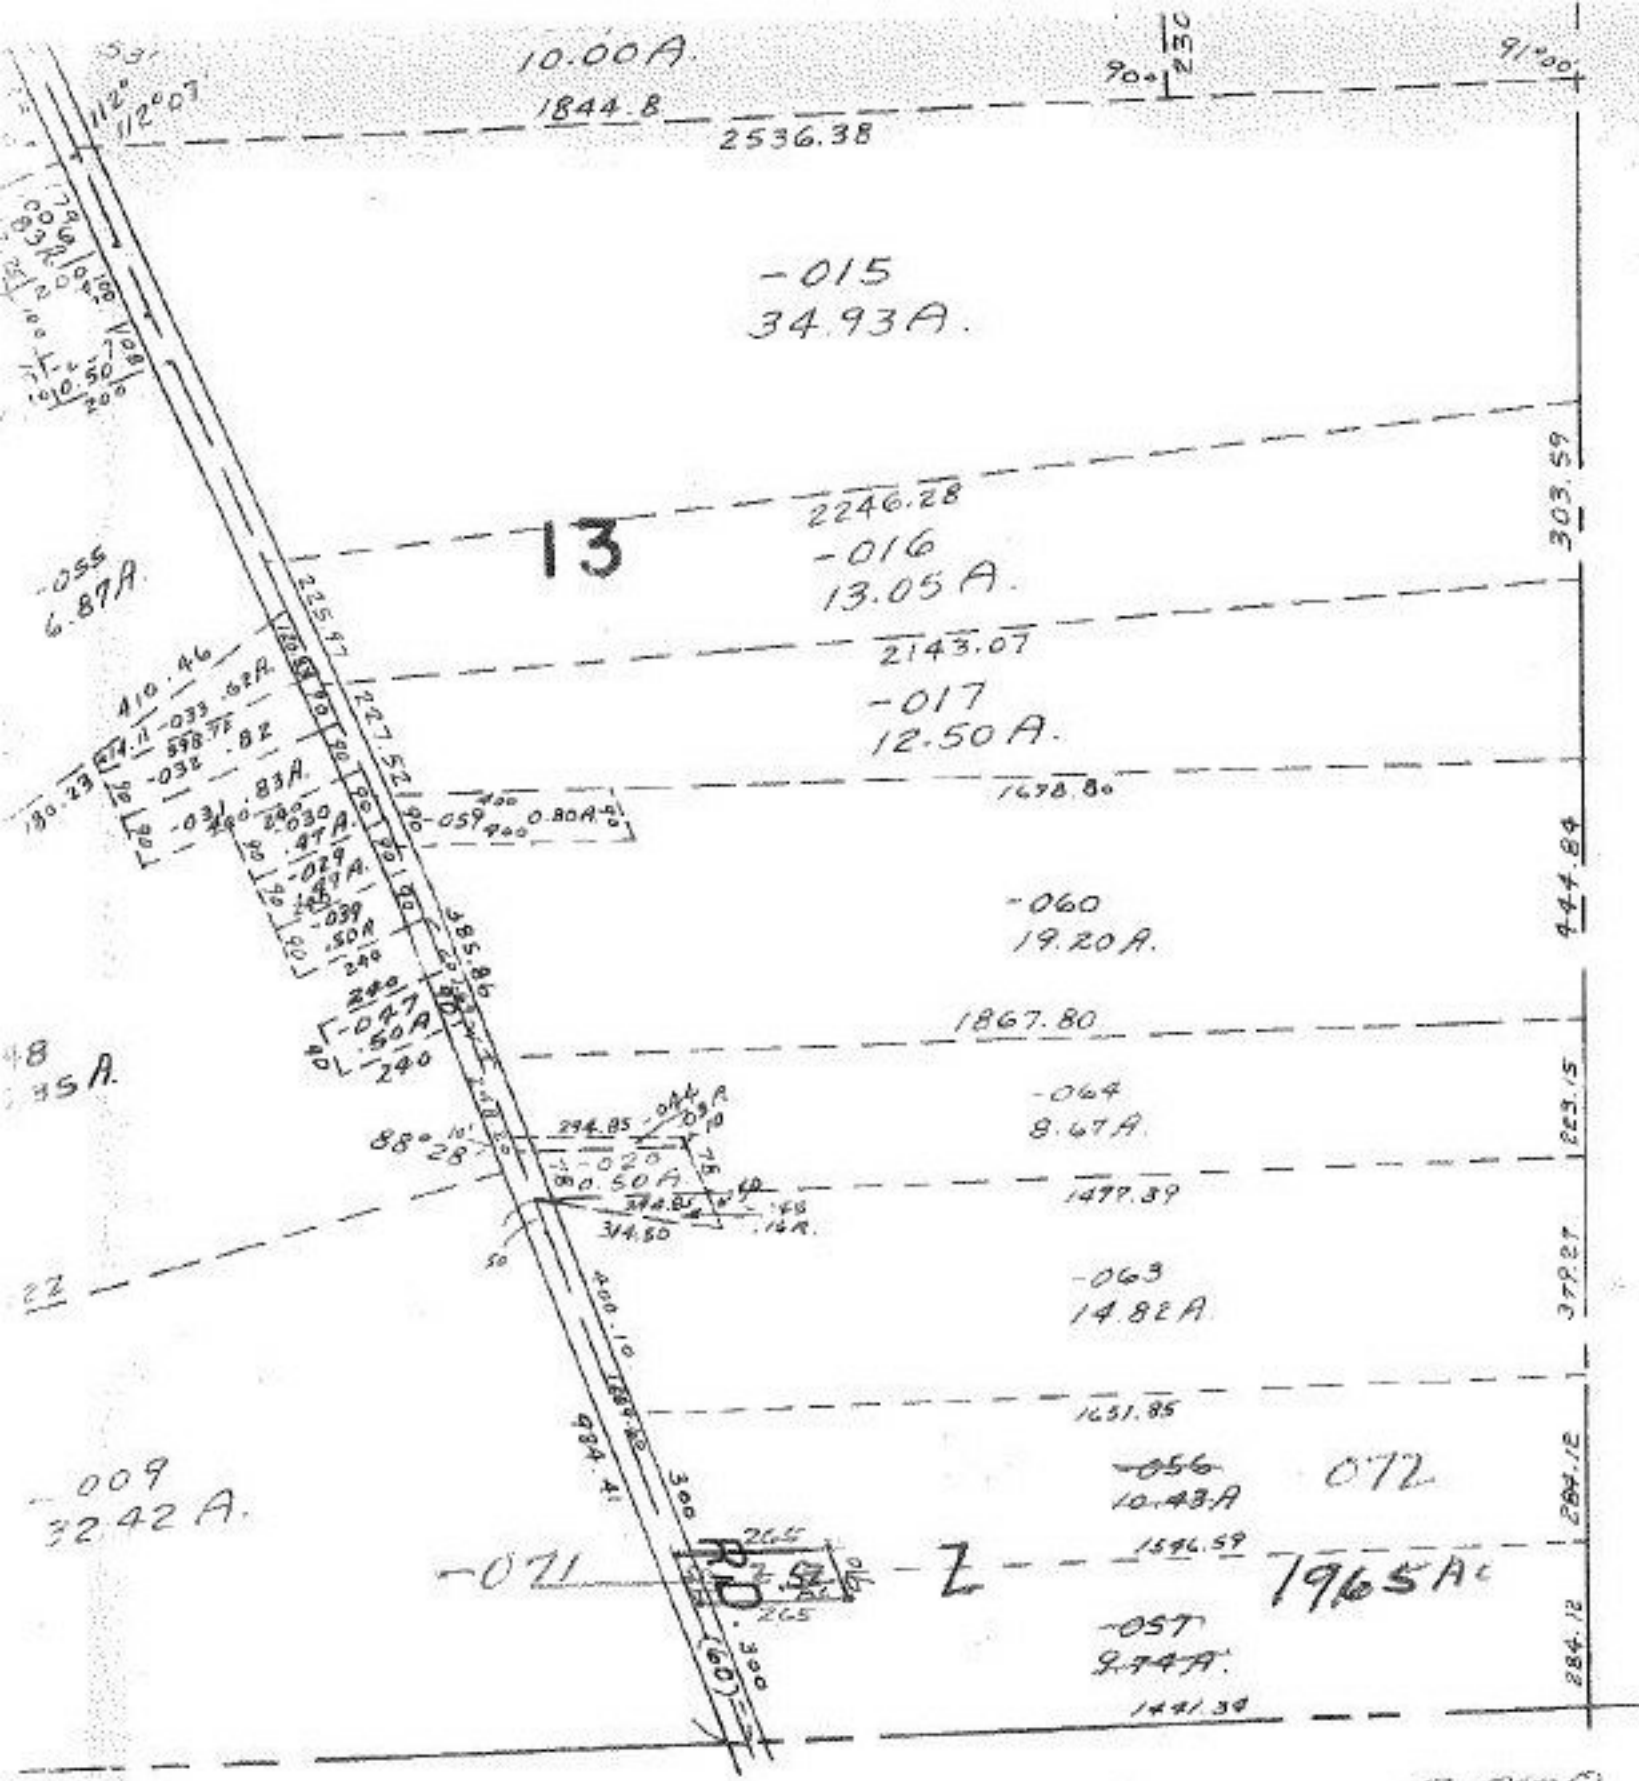

9978

APPROVED LORAIN CO. MAP DEPT.	
DATE	9/29/76
PAGE	76
BY	LW Hall
VOID AFTER	11:06 AM

JAN 18 1977

OCT 5 1976

LOTS 13, 14, 15, 22, 23 & 24